


S. 25, T 9 S R 2 W W M

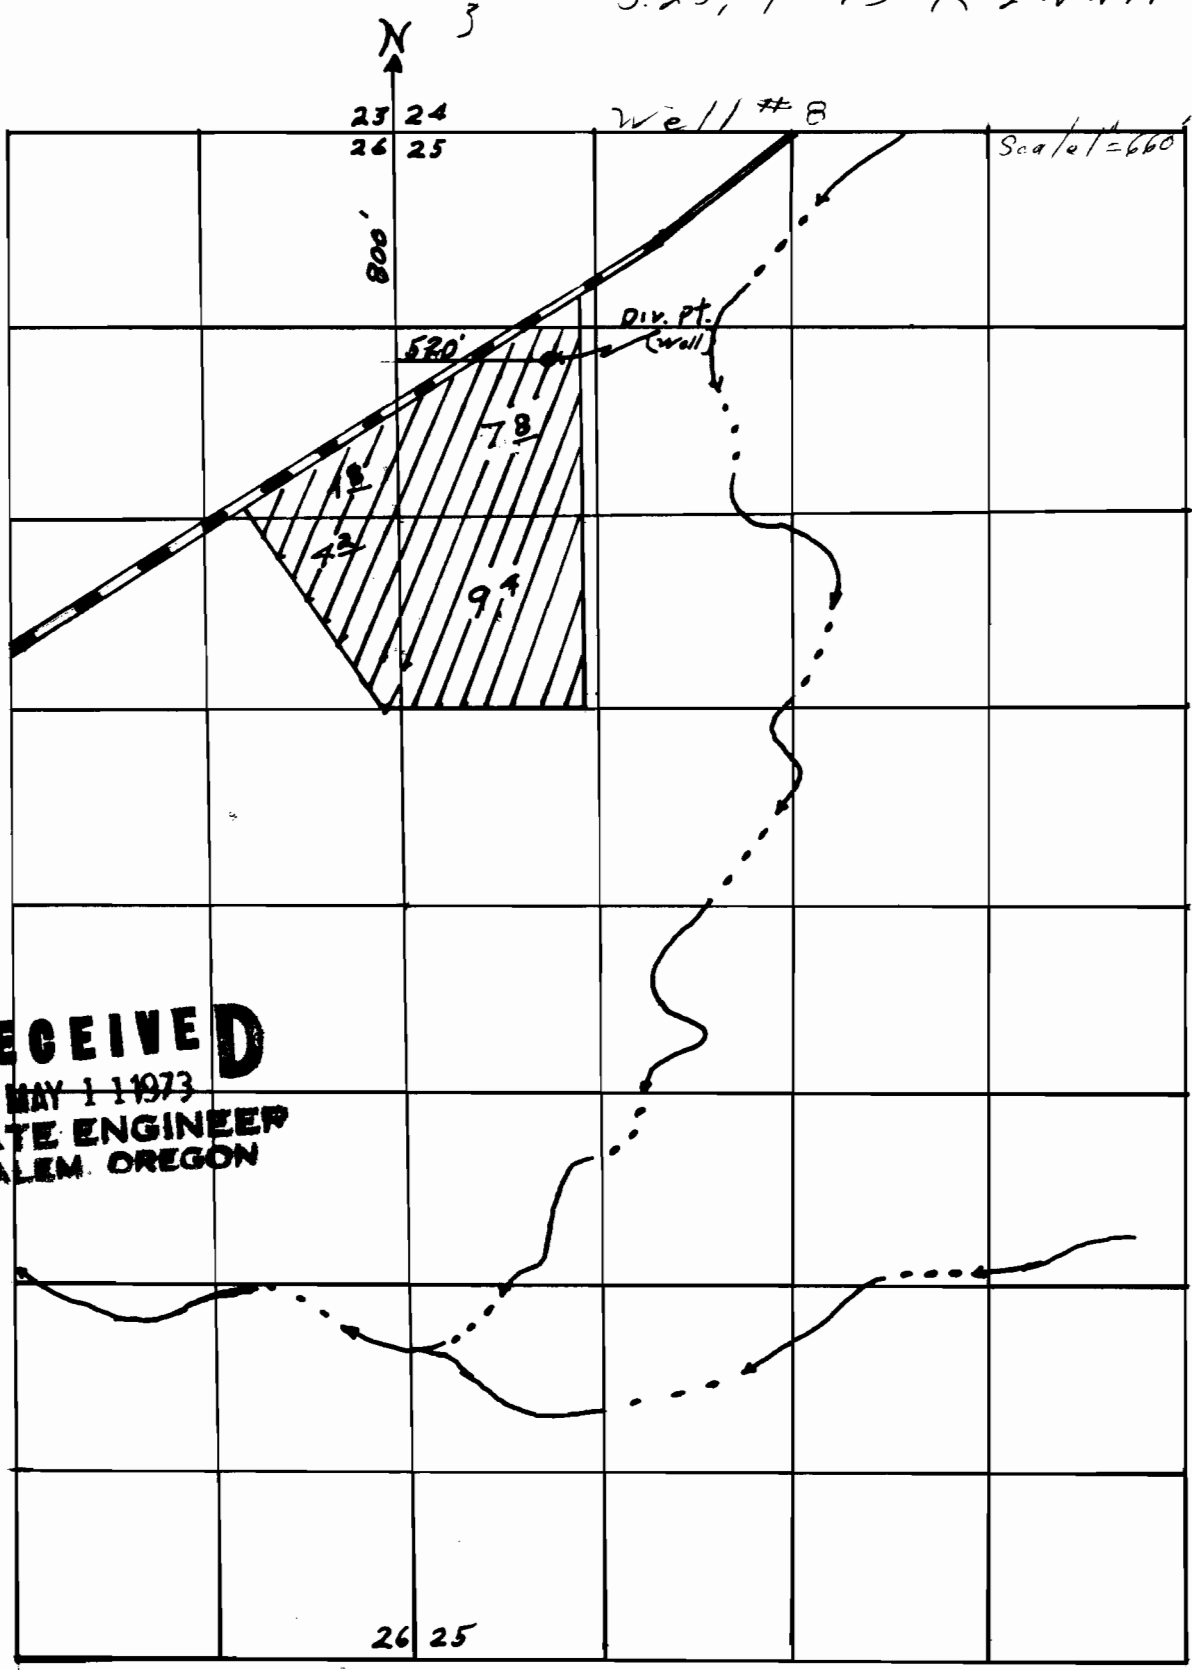

**RECEIVED**  
MAY 1 1973  
STATE ENGINEER  
SALEM, OREGON

Application No. G-6119  
Permit No. G-5793