


T.37S. R.1 W.W.M.  
T.38S. R.1 W.W.M.

RECEIVED

1969 11-4  
STATE ENGINEER  
SAC

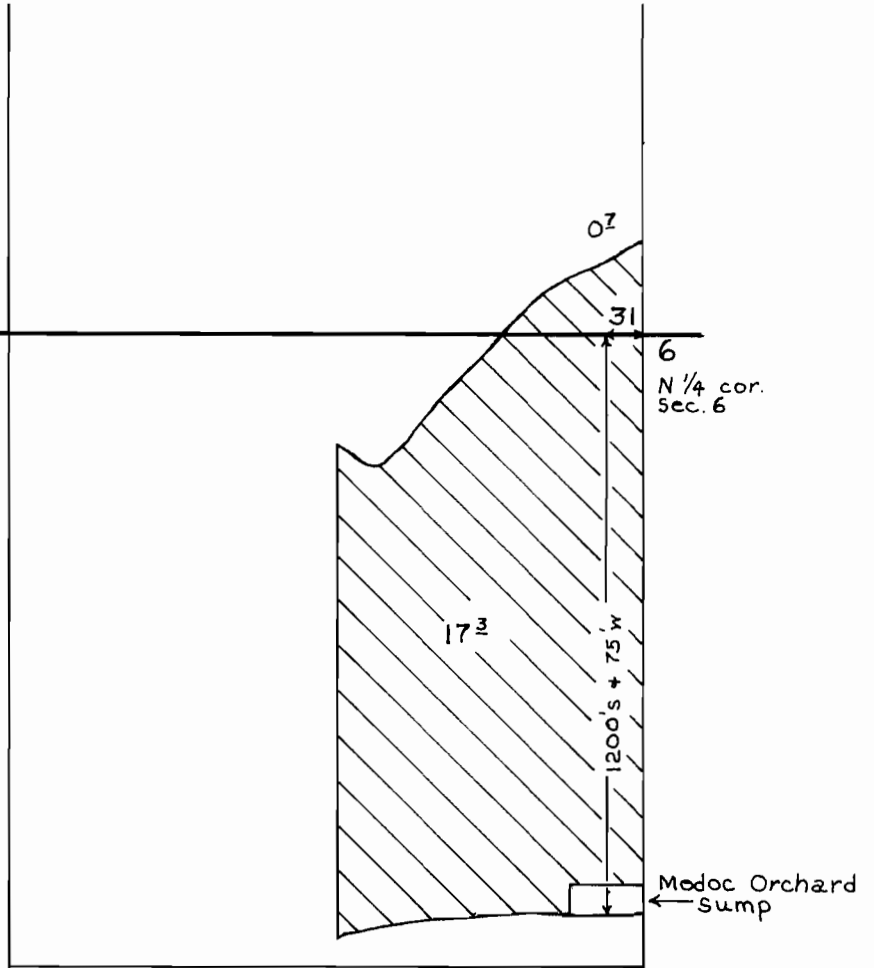

scale 1" = 400'



Map for Modoc Orchard for temperature control

Application No.  
Record No.

G-6407  
5-5805