


# T. 35 S., R. 6 W., W.M.

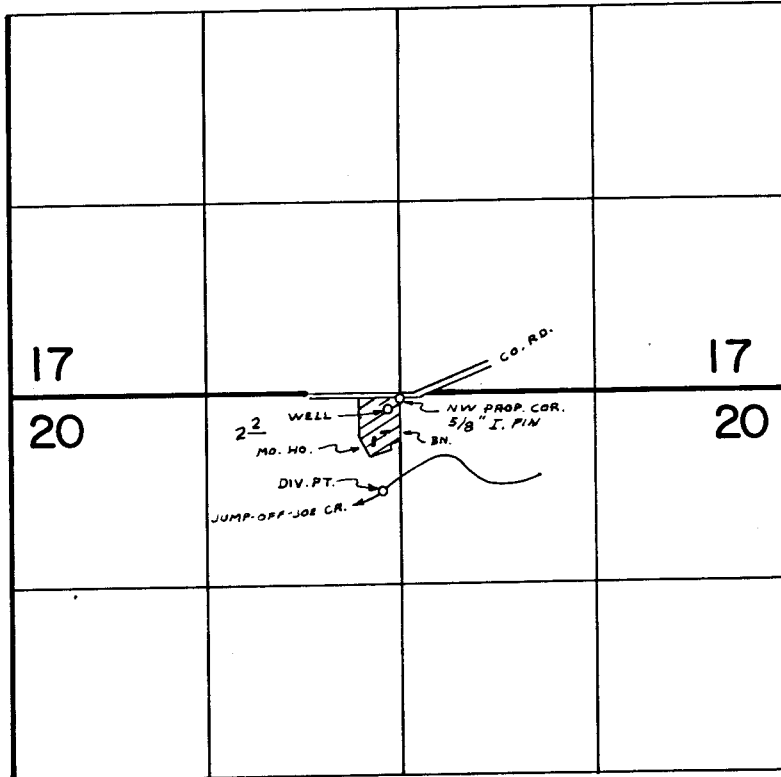

WELL LOC.: 100' S & 70' W FROM N<sup>1</sup>/<sub>4</sub> COR. SEC. 20  
 DIV. PT. LOC.: 680' S & 120' W FROM N<sup>1</sup>/<sub>4</sub> COR. SEC. 20

RECEIVED  
 MAY 19 1980  
 WM. DIST. 14  
 GRANTS PASS, ORE.

## FINAL PROOF SURVEY UNDER

Application No. G-6150 50565 Permit No. G-5821 38177 SUPPL. PRIMARY  
 IN NAME OF  
EARL A. BOLES  
 Surveyed NOV. 2 77 by B. SUND

P.T.S. - 1977-14-B