



T.41S., R.13W., W.M.

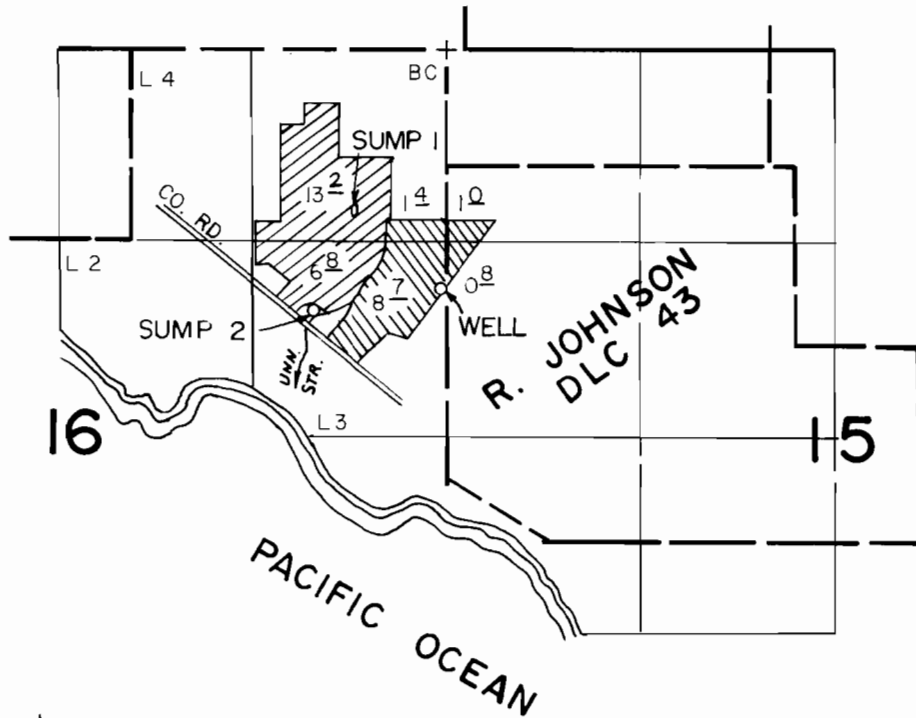

SOURCE:

SUMP 1 LOC. 1060'S, 635'W.
 SUMP 2 LOC. 1770'S, 905'W.
 WELL LOC. 1640'S, 40'W.

 APP. G-5691

ALL FROM NE CORNER SEC. 16

SCALE: 4" = 1 mile

 APP. G-7069

FINAL PROOF SURVEY UNDER

Application No. G-5691 Permit No. G-5825
~~G-7069~~ ~~G-6851~~
 IN NAME OF

GARY G. STRAHM

Surveyed APR. 11, 1985, by J. E. Cashman