


T. 38 S., R. 8 W., W.M.

RECEIVED

JUL 22 1981

WM. DIST. 14
GRANTS PASS, ORE

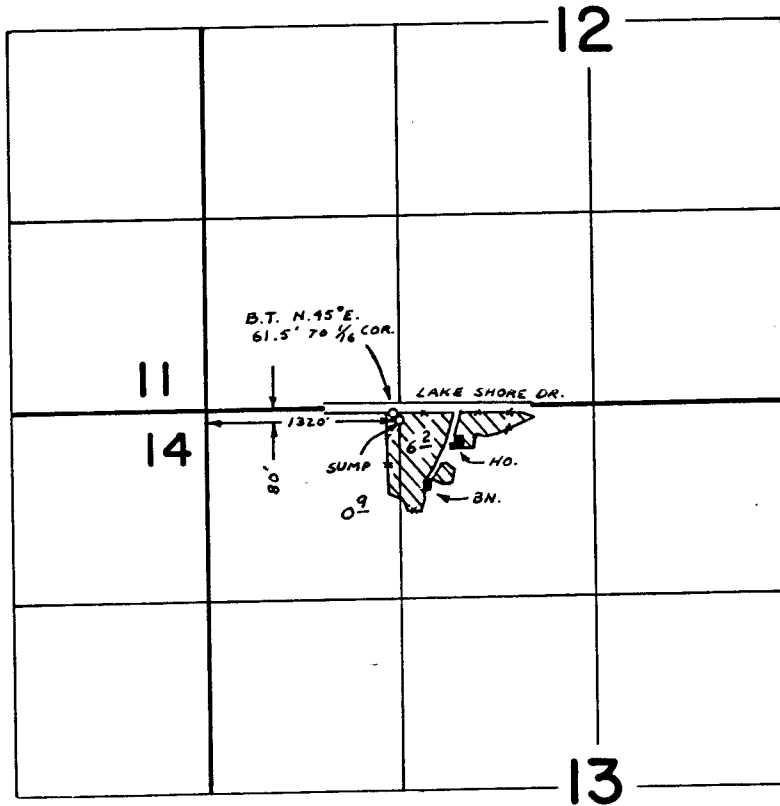

FINAL PROOF SURVEY
UNDER

Application No. G-6137 Permit No. G-5831
IN NAME OF

DON OLIPHANT

Surveyed JUL. 19 1978 by B. SUND

P.T.S. - 1978 - 14 - A