


T. 37 S., R. 6 W., W.M.

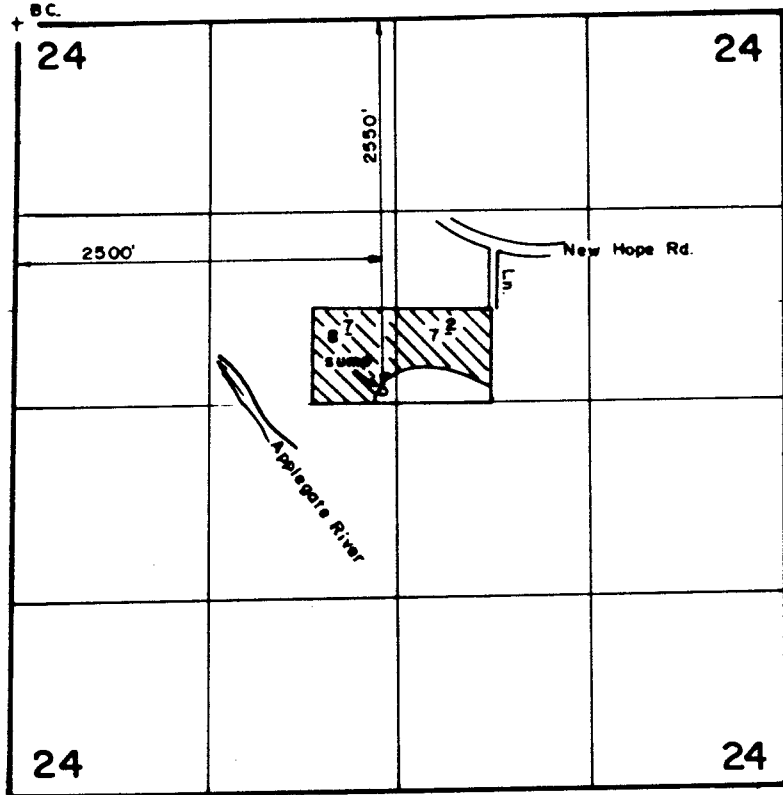

Scale: 1" = 1320'

RECEIVED

JUN 3 1988

WM. DIST. 14
GRANTS PASS, ORE.

FINAL PROOF SURVEY
UNDER

Application No. G-628 | Permit No. G-5912
IN NAME OF

SAMUAL MARKS & HARRY J. LA CHANCE, SR.

Surveyed JUL. 29 1986, by B. S. JAMES...

41033-179-924 144