


TU A

36 31

31 32  
T.39 S.  
6 5 T.40 S.

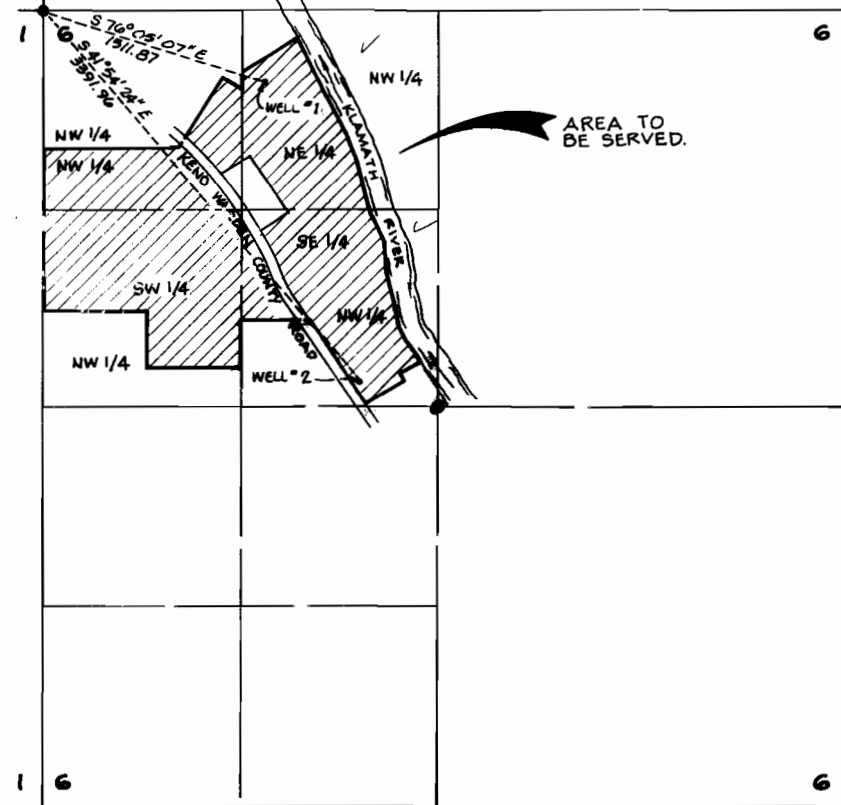

12 7

7 8

Application No. G-6302  
Permit No. G 5924