


T. 38 S., R. 3 W., W.M.

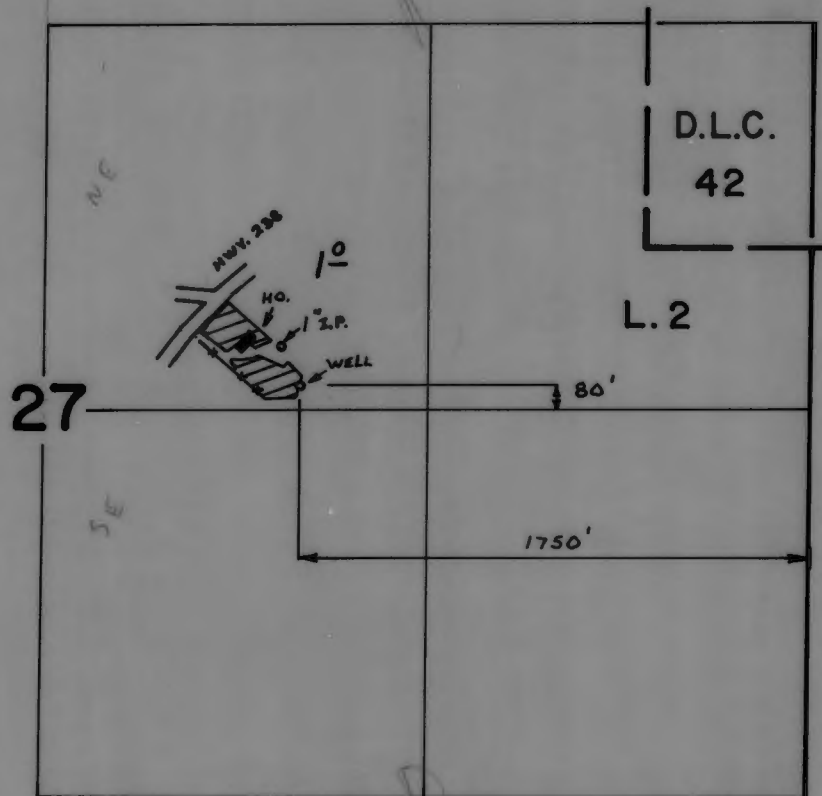

SCALE : 1" = 660 FT.

FINAL PROOF SURVEY
UNDER

Application No. G-6305 Permit No. G-5927
IN NAME OF

RICHARD F. & VIRGINIA C. SOUZA, SR.

Surveyed JUN. 12 1978, by B. SUND

D.H.M.
P.T.S. - 1978-14-A