


RECEIVED
MAR 6 1974
STATE ENGINEER
SALEM, OREGON

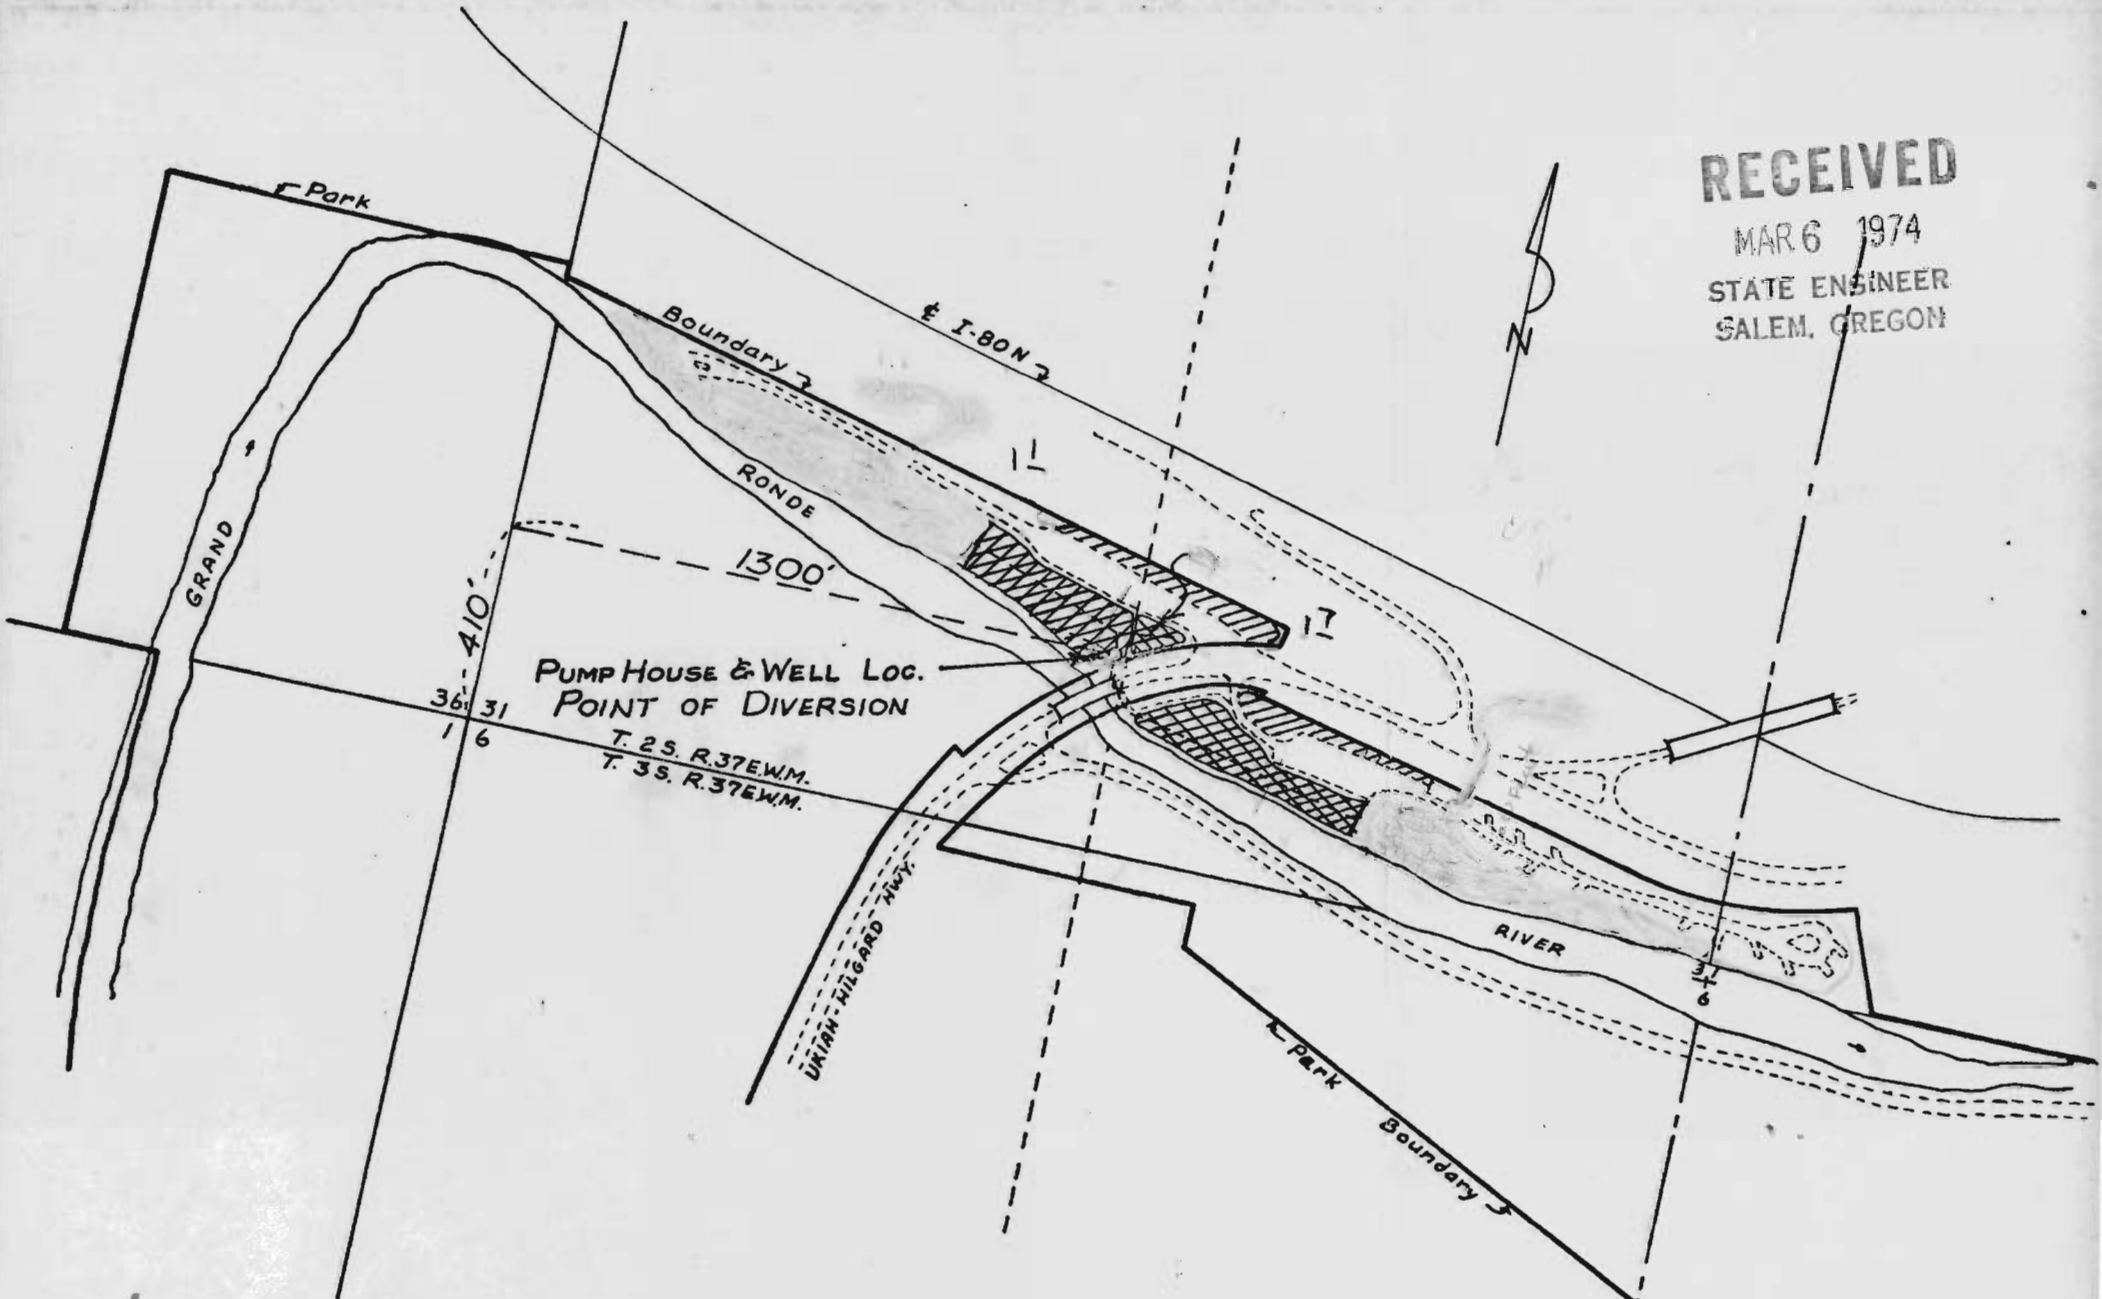

SKETCH MAP
HILGARD JUNCTION STATE PARK
APPLICATION FOR WATER RIGHT PERMIT
UNION COUNTY
SCALE 1" = 400' MARCH 1974

Application No. G-6453
Permit No. G 6053