


T.35 S., R.6 W., W.M.

F 7

JAN 30 1981

WM. DIST. 14
GRANTS PASS, OR 22

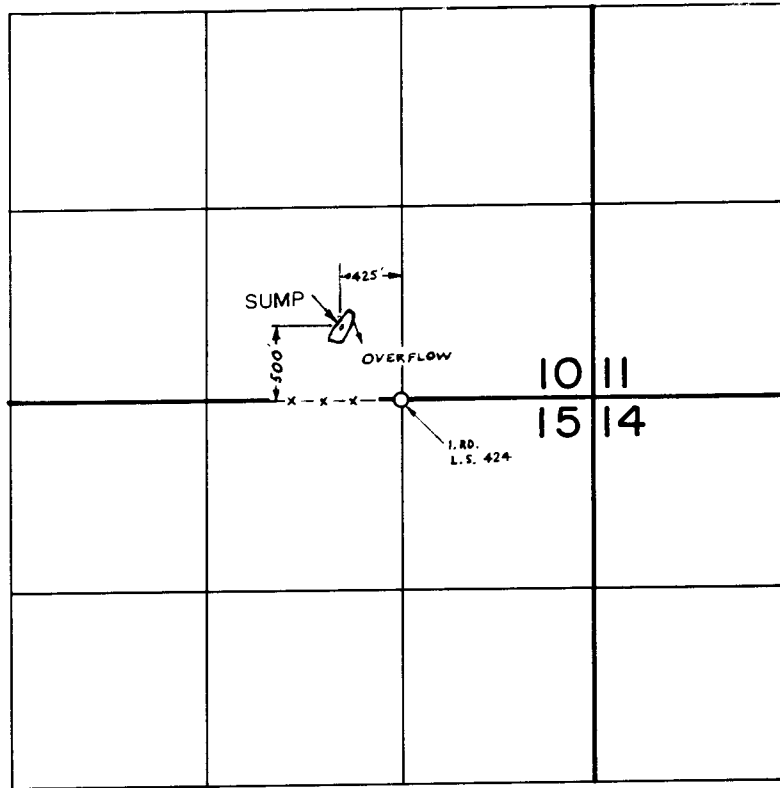

FINAL PROOF SURVEY
UNDER

Application No. G-6229 Permit No. G-6087
IN NAME OF

EDWIN L. ERNIE

Surveyed NOV. 2, 1977, by B. SUND

PTS 1977-14-B