


T.36S.R.6W.W.M.

RECEIVED

APR 29 1974

STATE ENGINEER
SALEM, OREGON

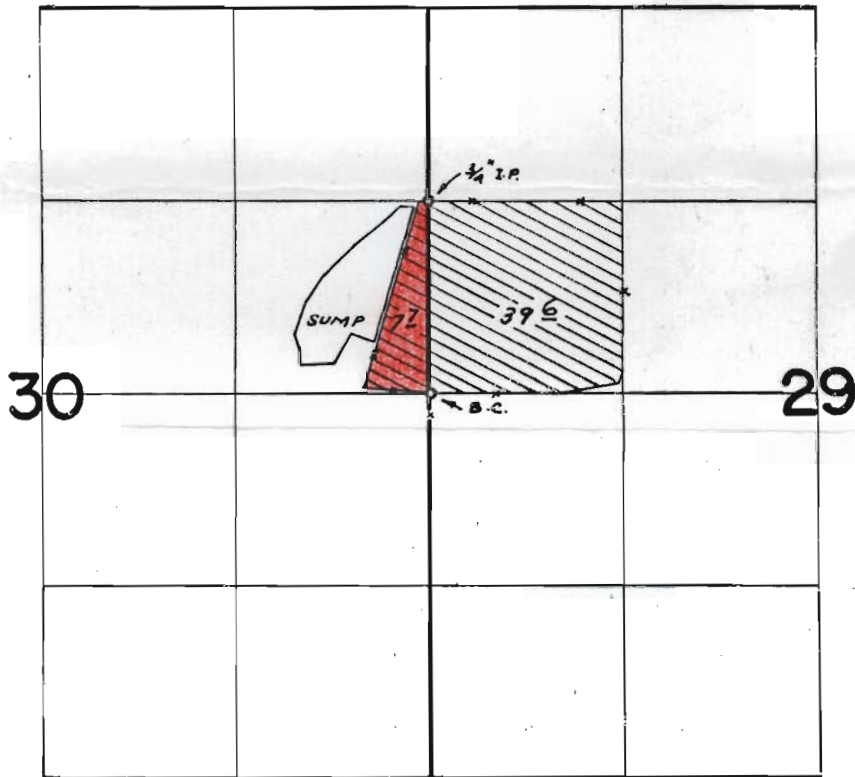

SUMP LOC: 700' N. & 500' W. FROM E 1/4 COR. SEC. 30

Land in red represent a new application

FINAL PROOF SURVEY
UNDER

RECEIVED

APR 12 1974

STATE ENGINEER
SALEM, OREGON

Application No. G-4359 Permit No. G-4113
IN NAME OF

THOMAS R. HART

Surveyed APR. 20 1972, by R. MUCKEN

1972-J

Application No. G-6516
Permit No. G 6128