


This sketch is accompanying the application and registration statements of Otto and Madge M. Nelson for rights to appropriate ground water of the State of Oregon.

Pertinent data shown thereon:

1. The location of the pump well, designated No. 3, as applied for and the area proposed to be irrigated therefrom.
2. The location of the pump wells, designated as No. 1 and No. 2 as described in their respective statements and area served.

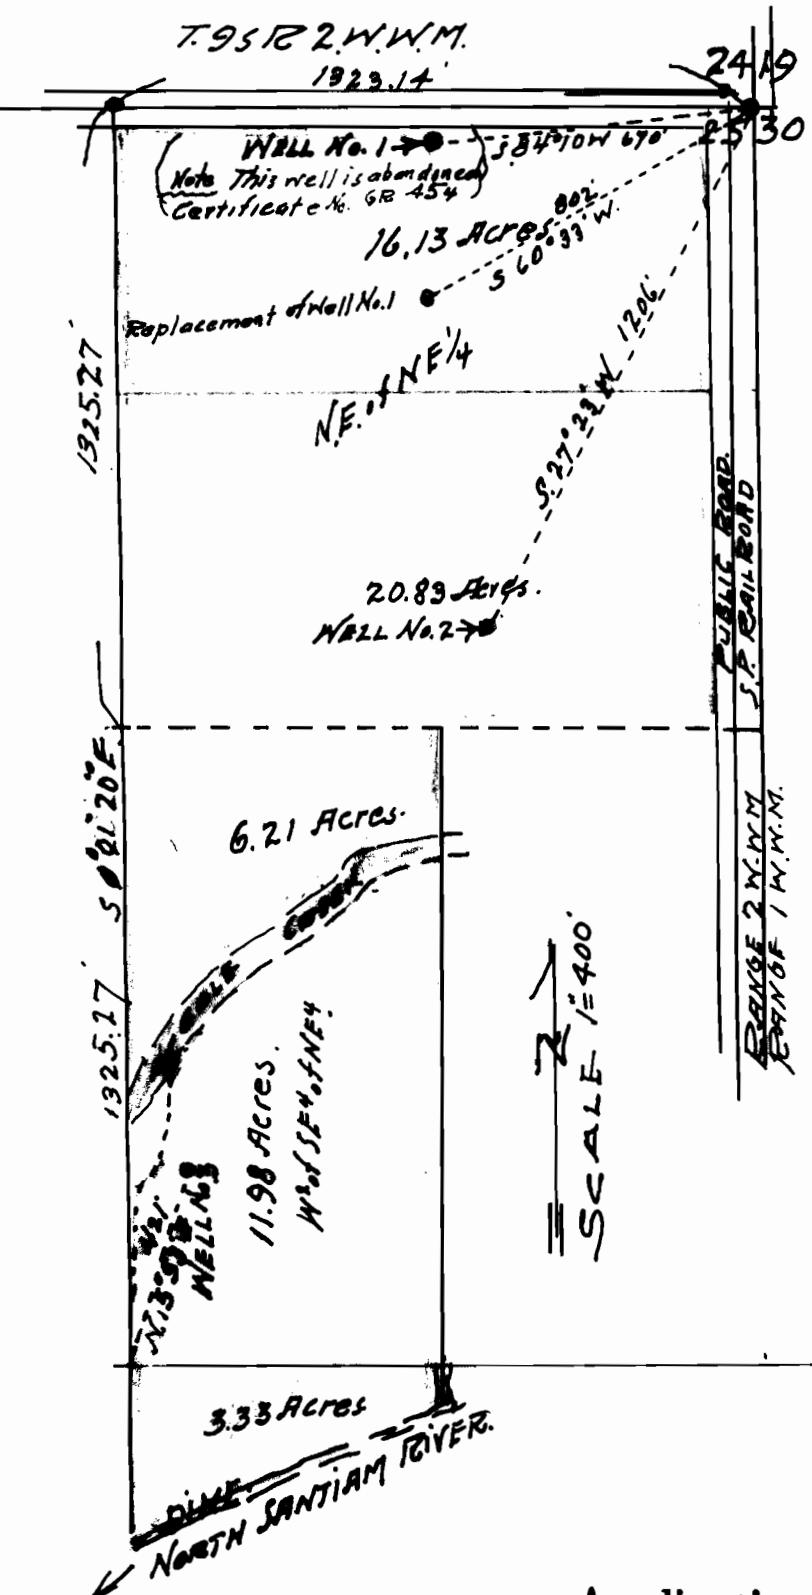

Note. Well here referred to as Well No. 1 is now abandoned as the water supply has dried up. This is to be replaced by a new well applied for in application hereto attached! The acreage to be served is identical to that listed for Well No. 1 that is now abandoned! Please note that Co/C Creek this year is bone dry all so, please note that Co/C Creek this year is bone dry that it ceases to be of value as an irrigation water supply.

Application No. G-716
Permit No. G-621