


R 26E

T 3S

Application No. G-6703  
Parcel No. ~~G-6247~~  
G-6247

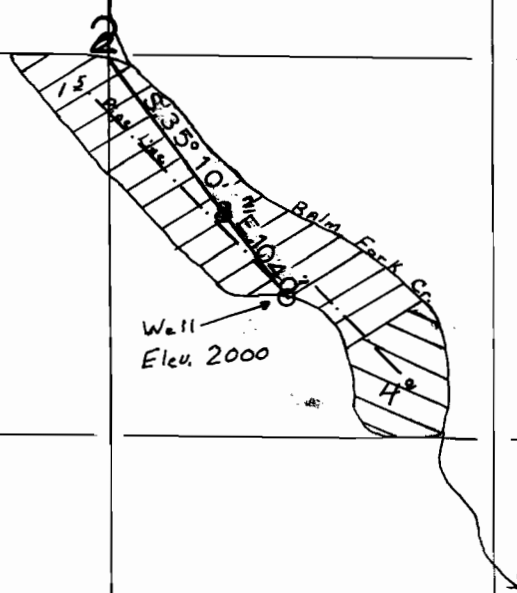

SCALE 8"/mi  
 SUPP //  
 PRI \\  
 PIPELINE ———