
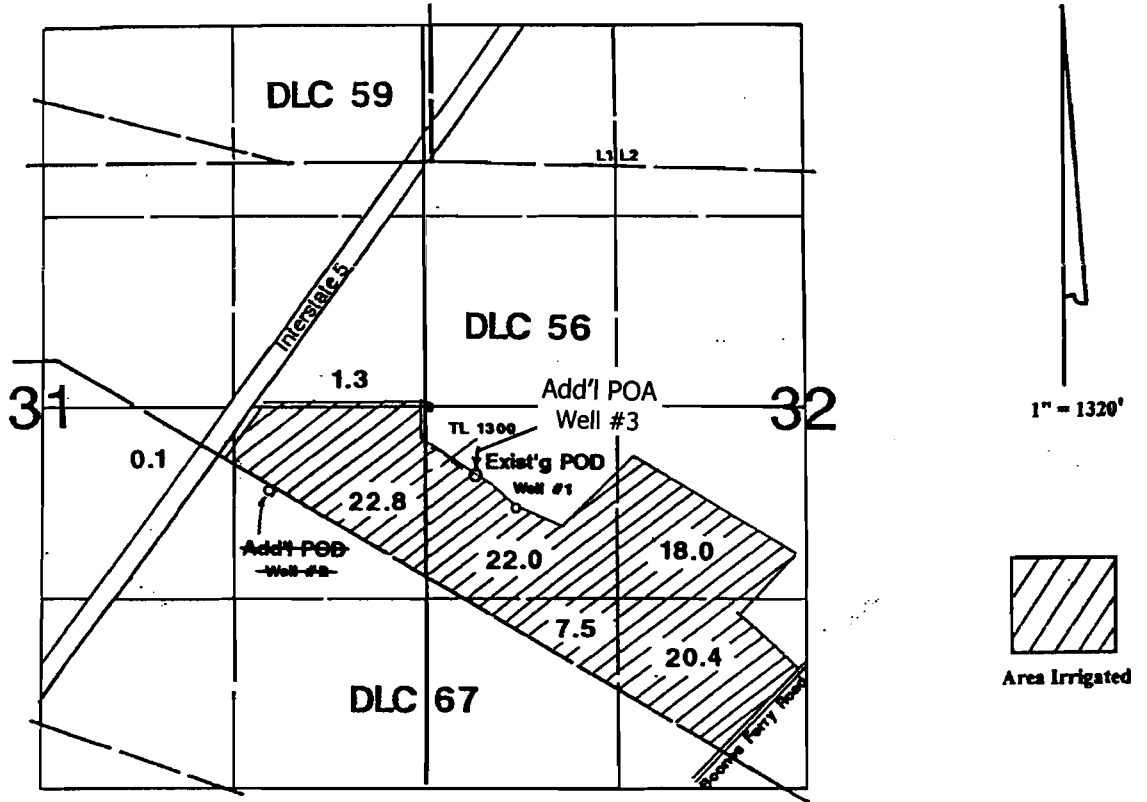


T.4S., R.1W., W.M

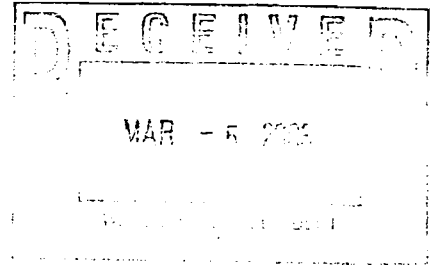




Well #1 is located 690'S & 620'E from the W1/4 corner of Section 32.
 Well #2 is located 590'S & 1070'W from the W1/4 corner of Section 32.
 Well #3: 450' S and 340' E from the W 1/4 corner section 32

Application Map

This map amended 6-1-2004 by:

Bizon Nursery

Transfer #:

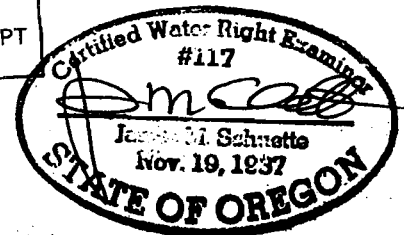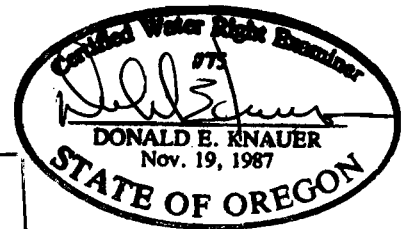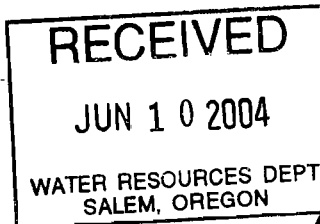

This Map Was Prepared For The Purpose Of Identifying The Location Of A Water Right Only And Is Not Intended To Provide Legal Dimensions Or Location Of Property Ownership Lines.

T 9367