


Application No. G 6771
Permit No. G 6289

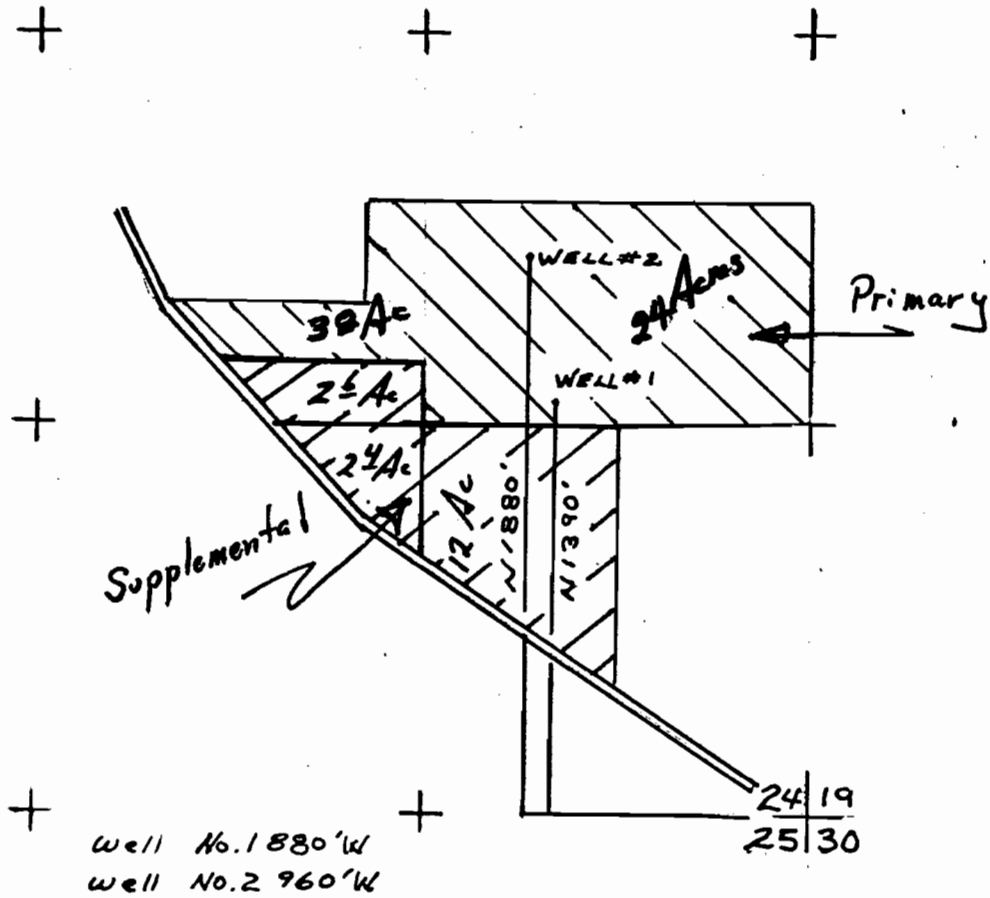

RECEIVED
JUN 25 1975
STATE ENGINEER
SALEM, OREGON

RECEIVED

SEP 30 1975
WATER RESOURCES DEPT
SALEM, OREGON

SCALE: 1"=660'

VAN VEEN NURSERIES, INC.