


T. 36S., R. 12E., W.M.

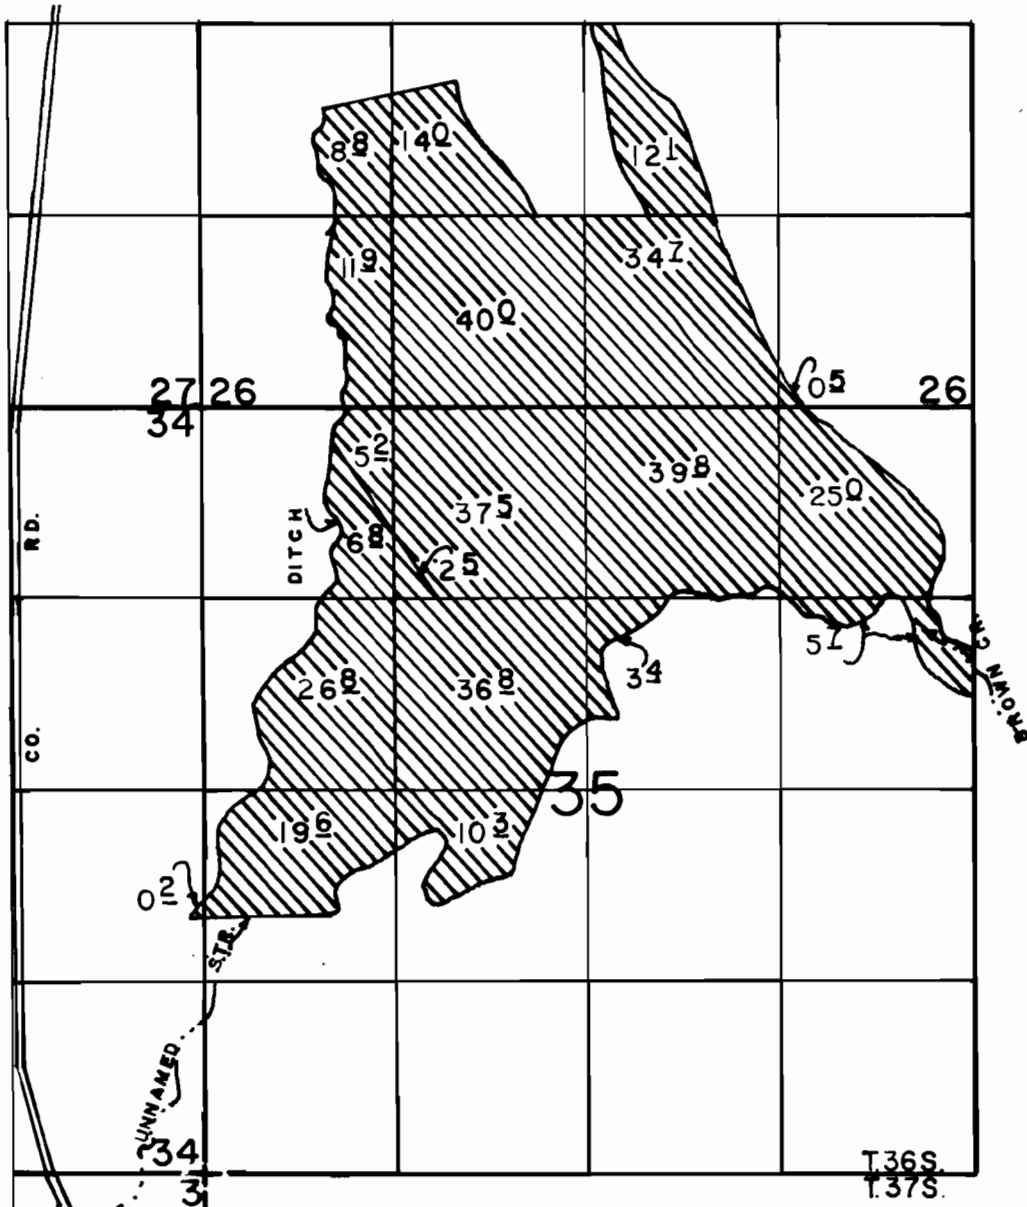

WELL LOC: 1620'S & 390'W
FROM NE COR. OF SEC 3.

SCALE: 1" = 1320'

FINAL PROOF SURVEY

UNDER

Application No. G-6828 Permit No. G-6323
IN NAME OF

FLYNN BROTHERS

Surveyed SEPT 14, 1991, by B.W. BISHOP
SUPPLEMENTAL