


T. 37 S., R. 5 W., W. M.

25

RECEIVED
JUN 16 1982
WM. DIST. 14
BRANIS PASS, ORE.

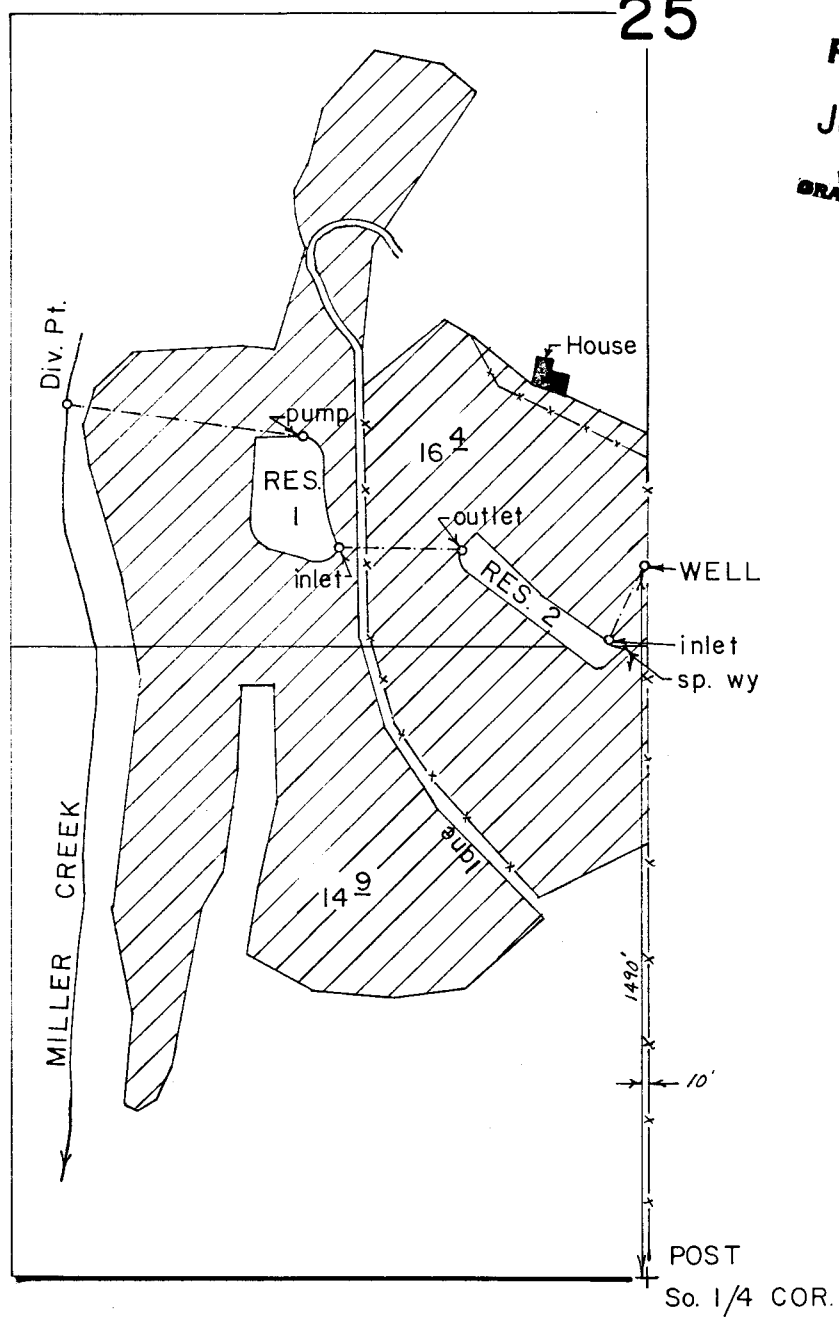

FINAL PROOF SURVEY
UNDER

Application No. G-7033 Permit No. G-6338...
IN NAME OF

WILLIAM H. & RUTH A. SPENCER

Surveyed JUNE 21, 1979, by B.R. SUND.....

Scale: 1" = 400'

PTS-1979-14C