

Lone

RECEIVED

MAR 13 1974

STATE ENGINEER  
SALEM, OREGON


T.15 S. R.48.5 W. W.M

N

RECEIVED

MAY 8 1974

STATE ENGINEER  
SALEM, OREGON

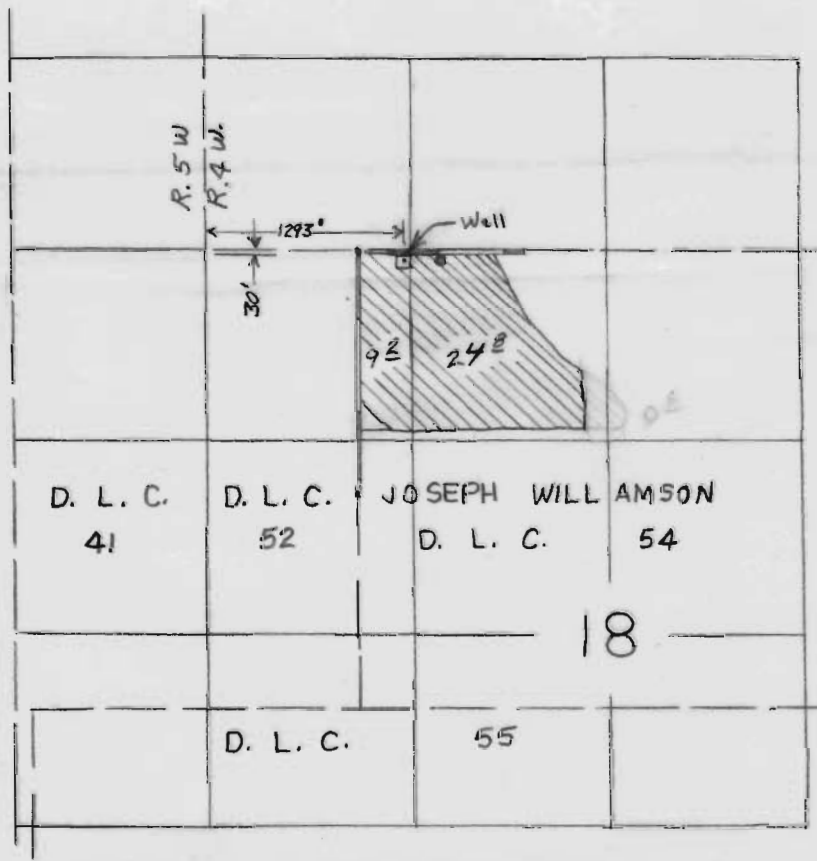

RECEIVED

OCT 8 1974

STATE ENGINEER  
SALEM, OREGON

Application No. G 6464

RAYMOND JAGER

Permit No. G 6365