


T. 40 S., R. 8 W., W.M.

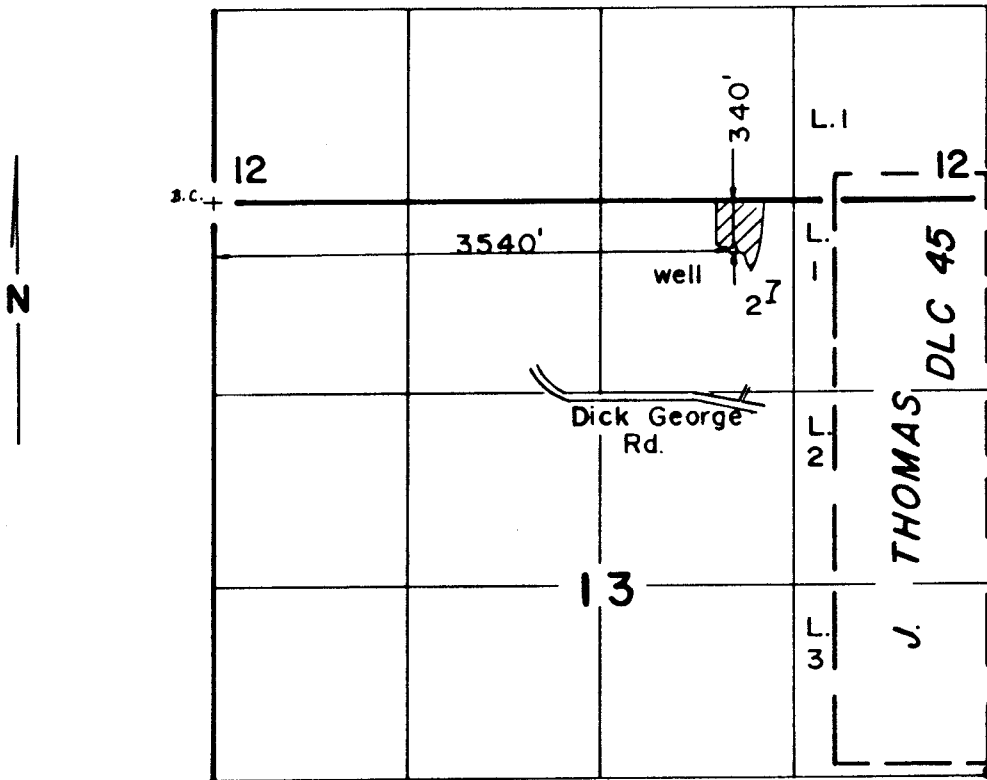

Scale: 1" = 1320'

RECEIVED
MAY 6 1988
WM DIST. 14
GRANTS PASS, ORG.

FINAL PROOF SURVEY
UNDER

Application No. ~~G-6854~~ Permit No. ~~G-6393~~
IN NAME OF

JAMES R. FRANKS

Surveyed APR. 2, 1986, by B. S. JAMES