


RECEIVED
MAY 2 1975
STATE ENGINEER
SALEM, OREGON

T.5S. R.2W. W.M.

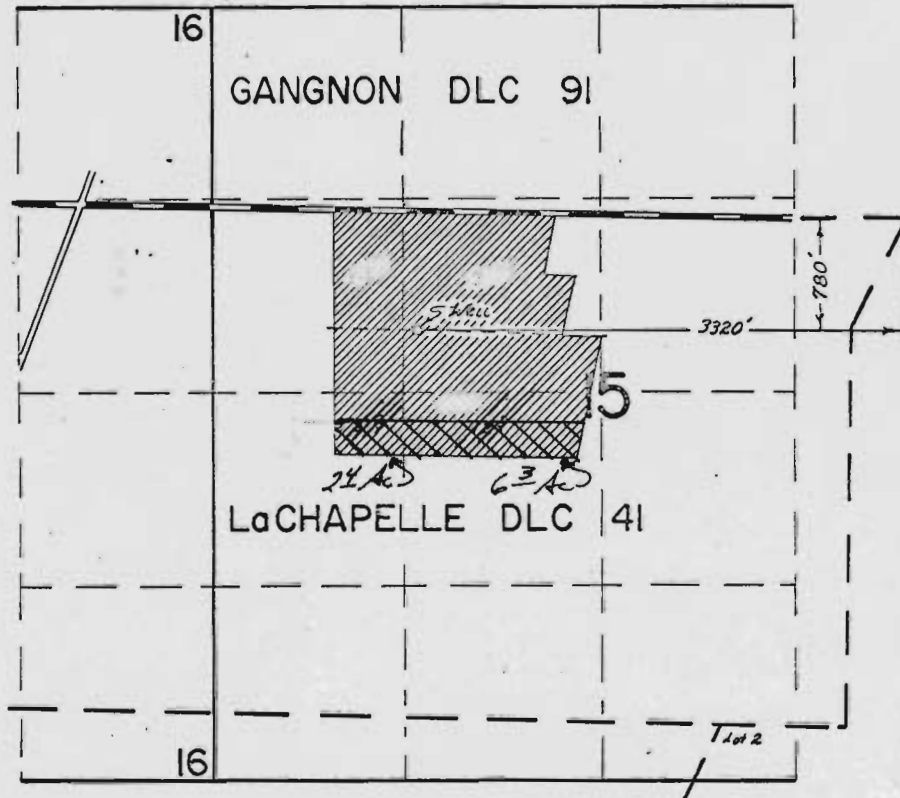

Application No. G-6928
Permit No. G 6446

FINAL PROOF SURVEY
UNDER

Application No. G-4492 Permit No. G-4234
IN NAME OF

LEONARD R. FERSCHWEILER

Surveyed MAY 22 1973 by T.J. Paul