


SEE MAP  
IN 3 28

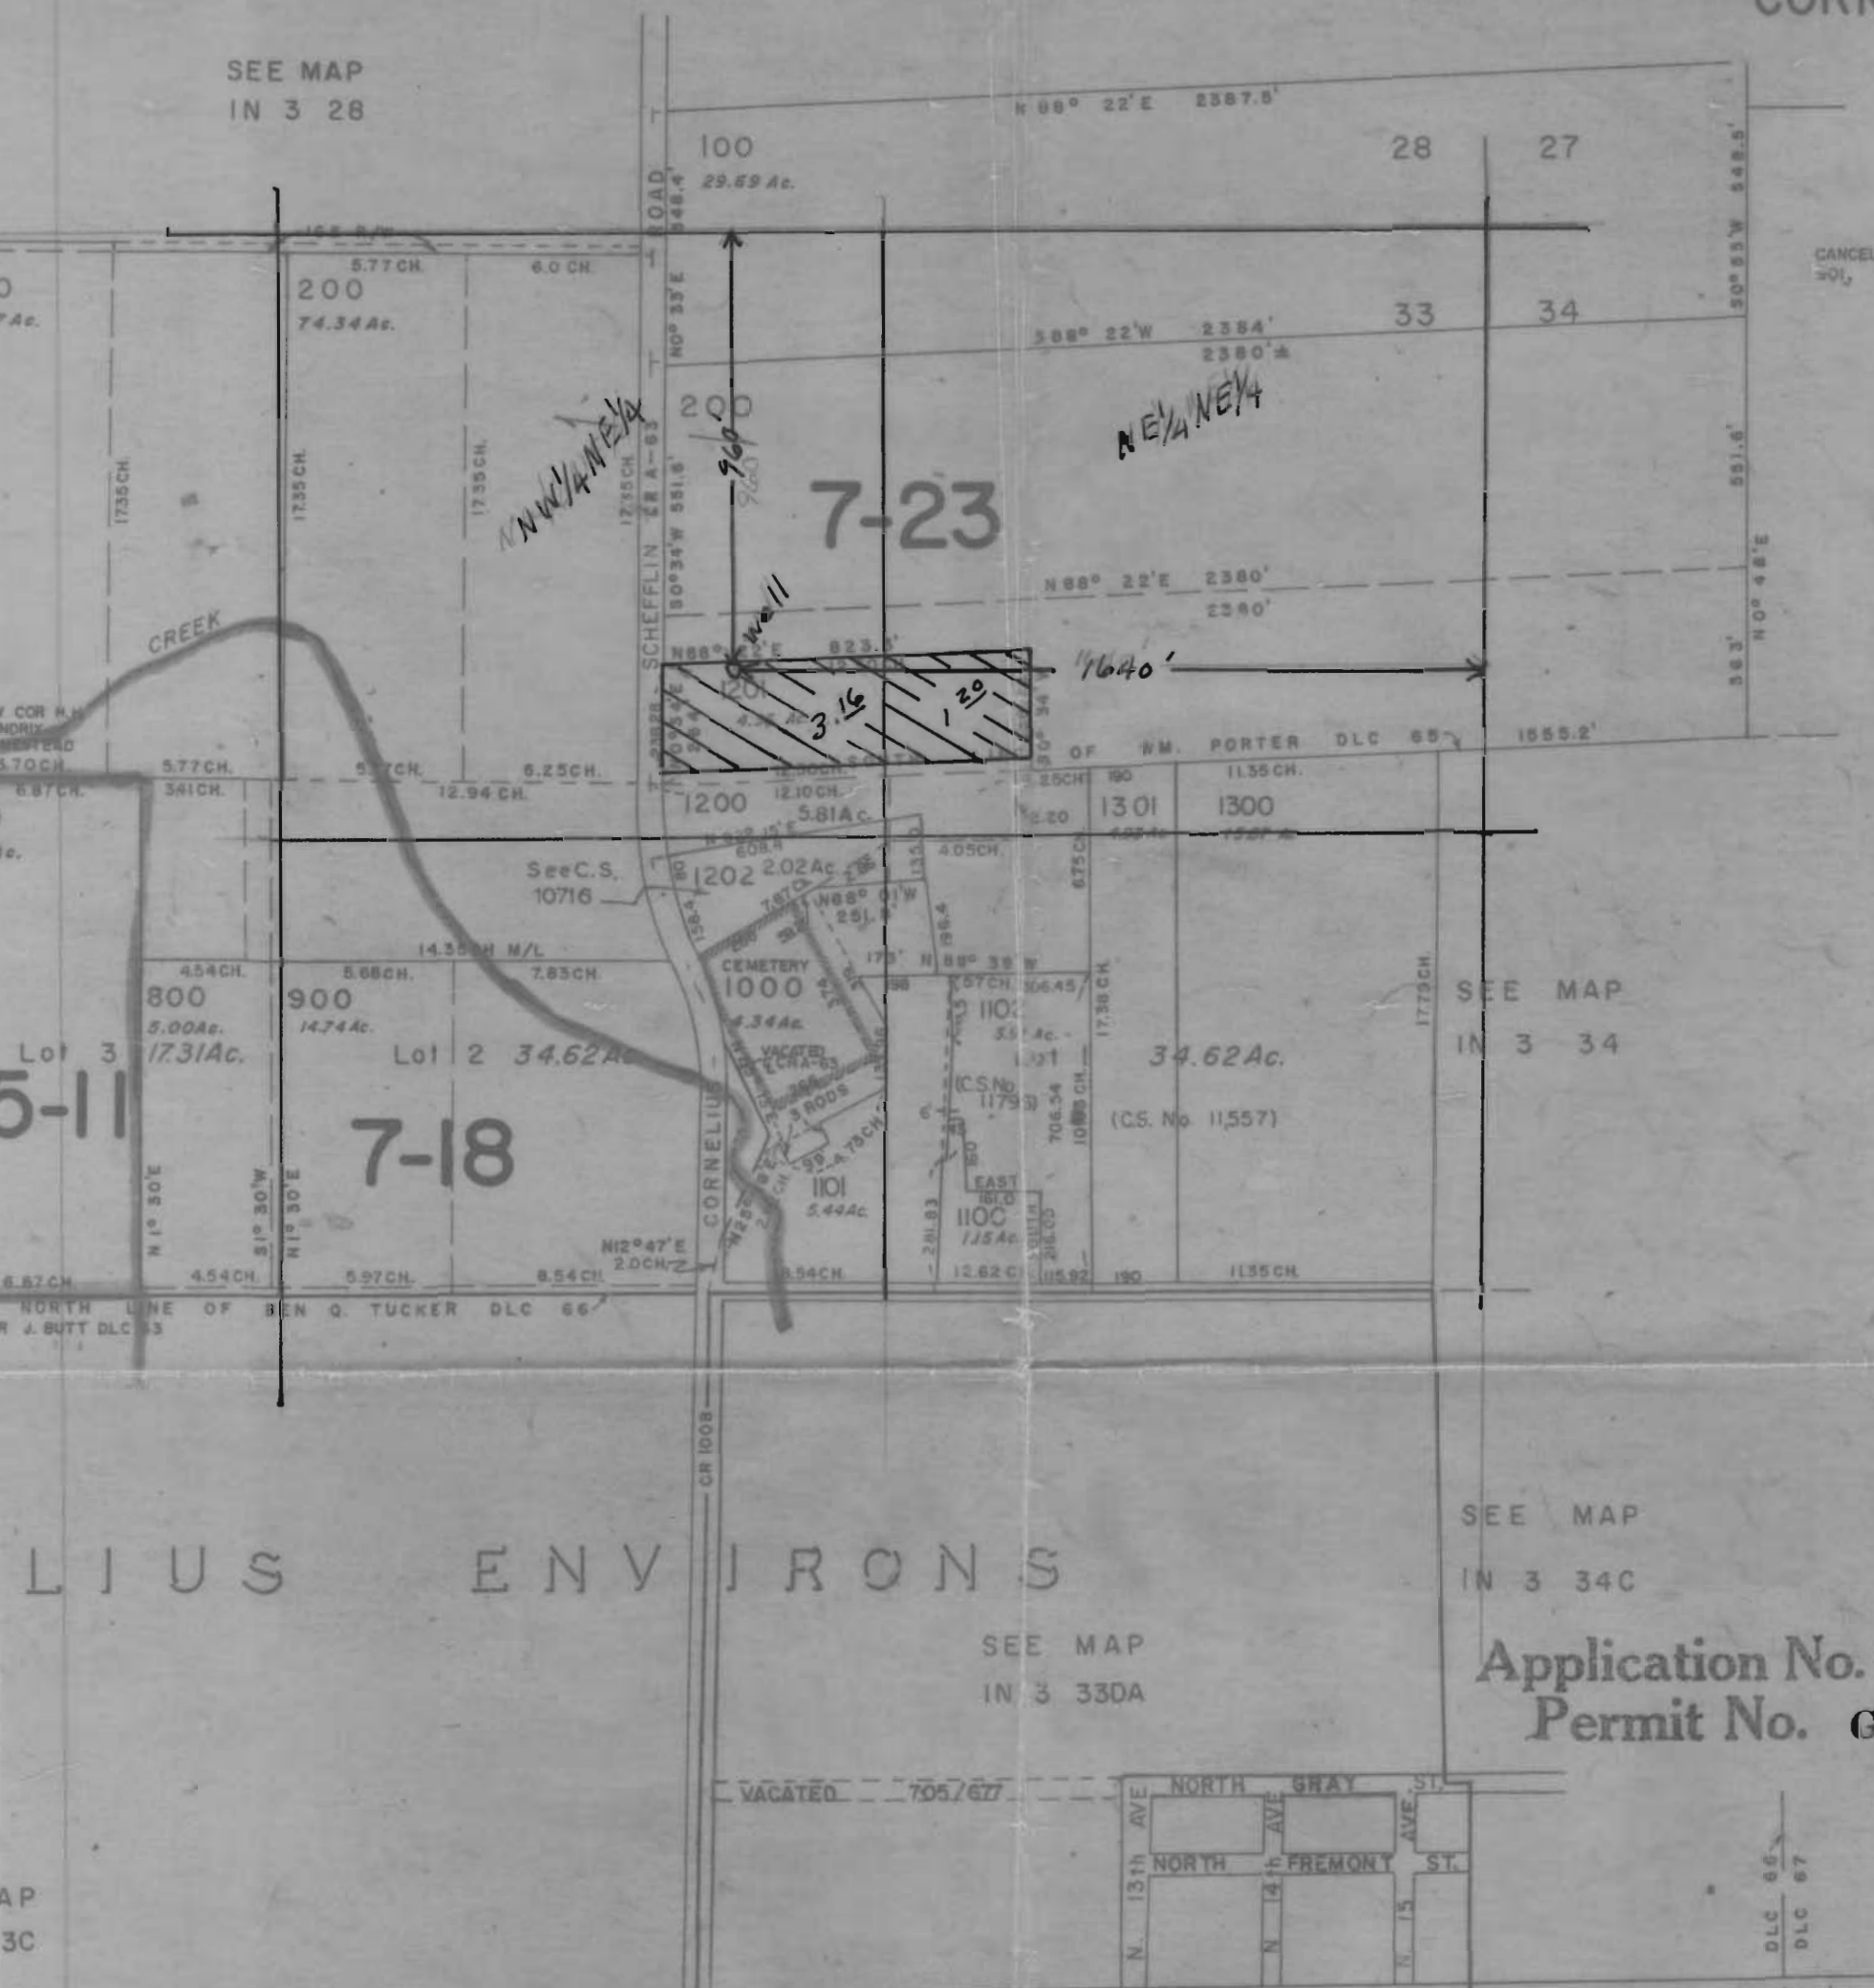

CANCELLED TAX LOTS  
901,

7-23

7-18

5-11


SEE MAP  
IN 3 34

SEE MAP  
IN 3 34C

SEE MAP  
IN 3 33DA

Application No. G-6931  
Permit No. G 6419

CORNELIUS ENVIRONS

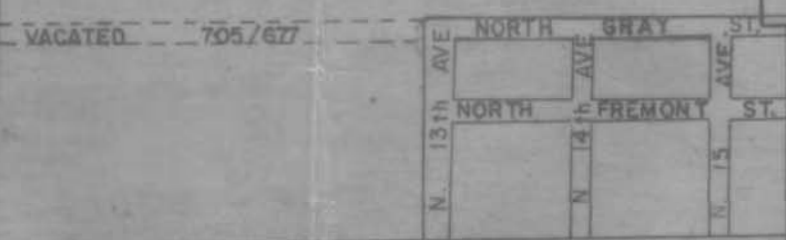

RECEIVED  
MAY 5 1975  
STATE ENGINEER  
SALEM, OREGON

APR 3 0 1975

SEE MAP  
IN 3 A

43900 -  
CORNELIUS  
& INDEX  
IN 3 33