

SECTION PLAT

RECEIVED

Section 18


Township 24 S.

Range 30 E MAR 31 1975

County of Harney State of Oregon

STATE ENGINEER
SALEM, OREGON

NORTH

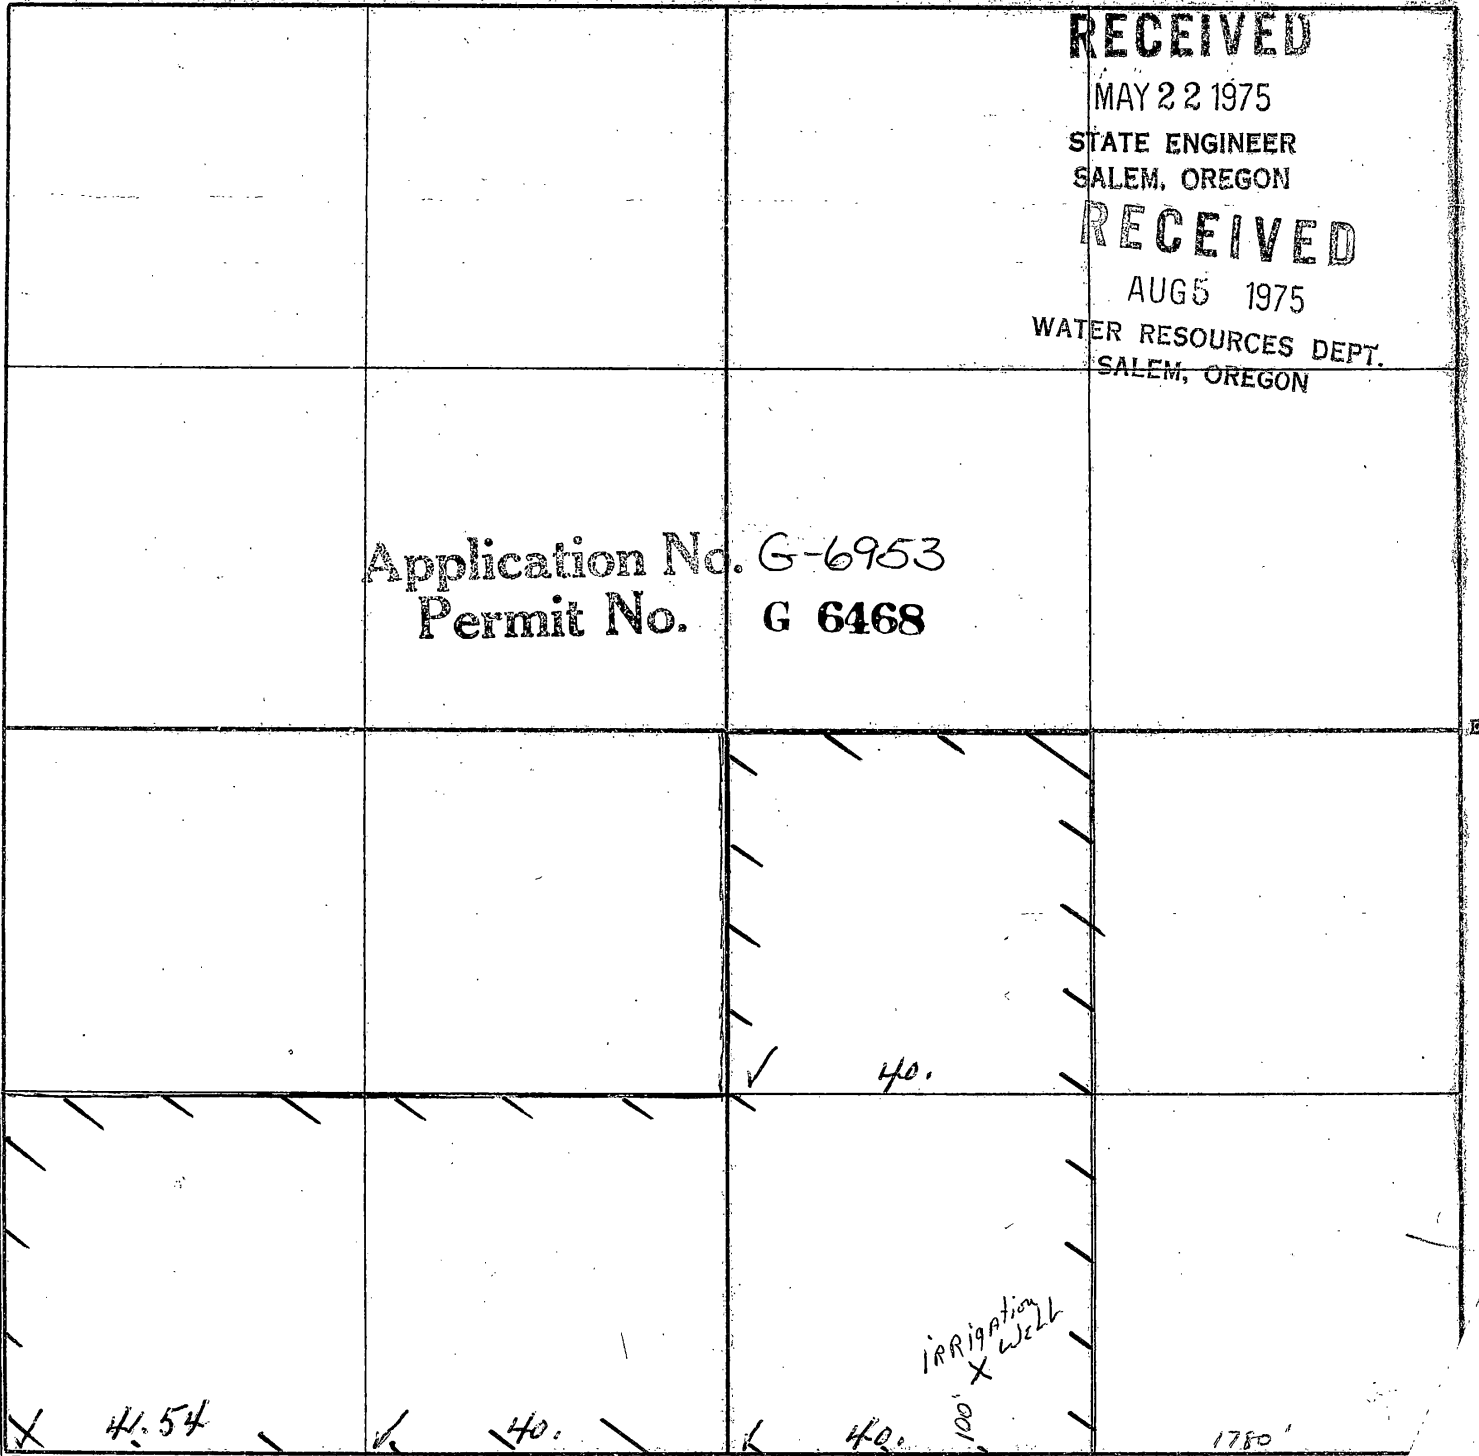

Remarks (scale - 8" = 1 mile - 660) -

SE 1/4 SW 1/4 W 1/2 SE 1/4 Lot 4

[Handwritten signature]