


T.9S., R.1E., W.M.

Application No. G-6960
Permit No. G 6472

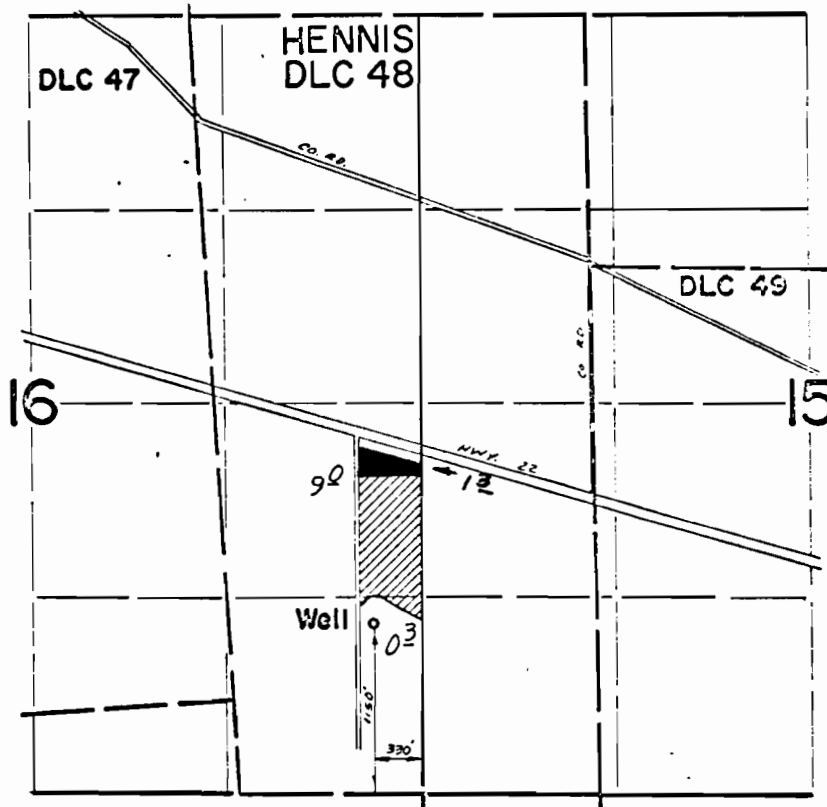

FINAL PROOF SURVEY
UNDER

Application No. G-4502 Permit No. G-4244
IN NAME OF

VERNON R. MORGAN

Surveyed July 3, 1973, by D. Norby