

ARVID BACKMAN


SECS. 8 & 9, T. 11 S., R. 2 W., W.M., LINN CO., ORE.

Scale : 1" = 10 Chains

April 2, 1957

ORRIS A. CARNEGIE

DEP. CO. SURVEYOR

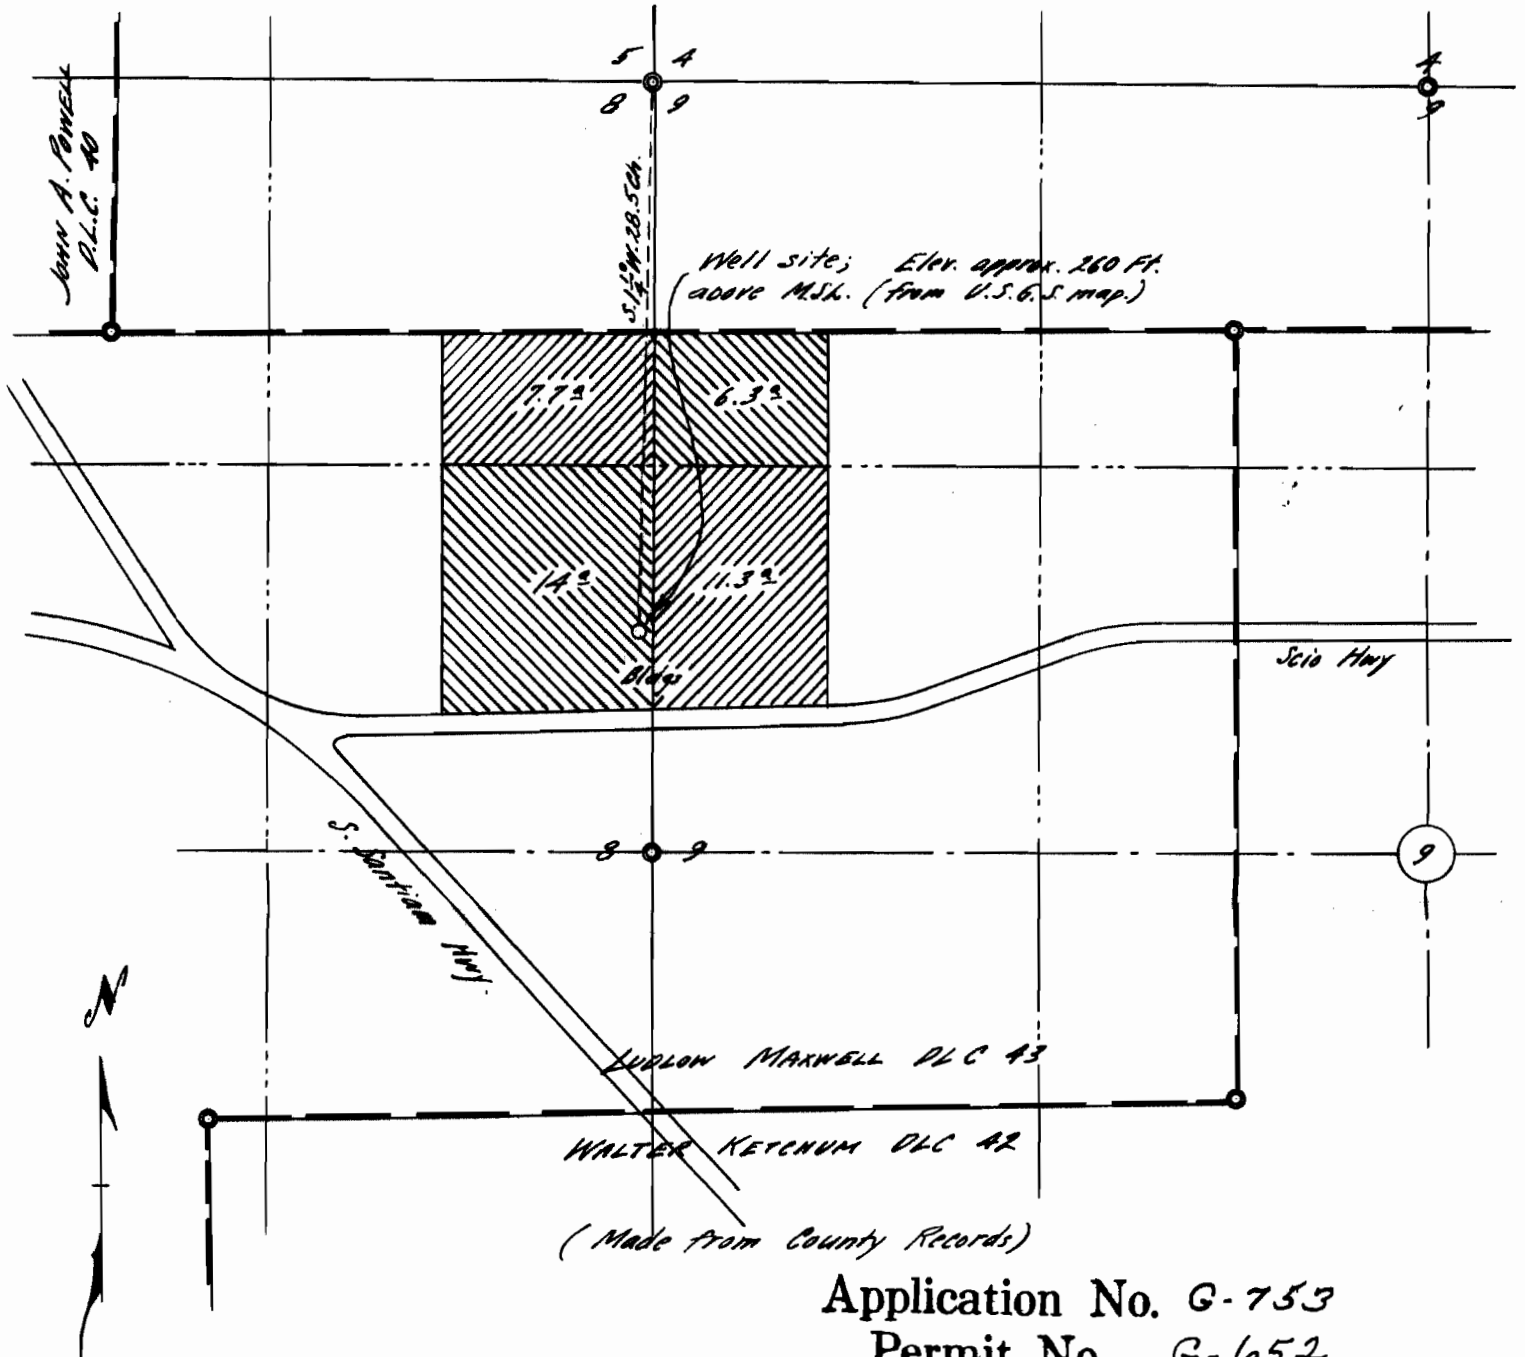

Application No. G-753

Permit No. G-652

