


30

29

REFERENCE PT. 31

NORTHEAST CORNER SECTION 31, BRASS CAP IN CONCRETE MONUMENT.

NE CORNER SEC 31, T15S-R4W W.M.

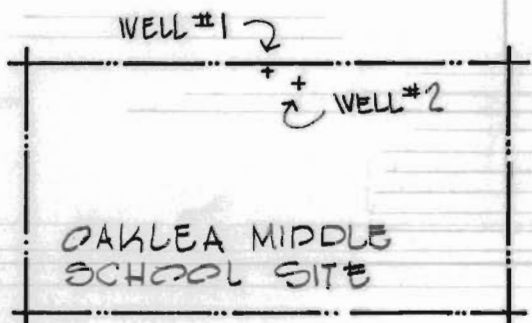

WELL #1, 914.43' SOUTH & 1809.36' W OF REFERENCE PT.

WELL #2, 940.43' SOUTH & 1744.36' W OF REFERENCE PT.

OAKLEA MIDDLE SCHOOL SITE

Application No. G-7090  
Permit No. G 6558

NORTH



← QUARTER SECTION LINES

RECEIVED

AUG 27 1975

WATER RESOURCES DEPT.  
SALEM, OREGON

PROPOSED WELL LOCATIONS FOR OAKLEA

MIDDLE SCHOOL.

SCALE = 1" = 400'