


T. 38 S., R. 5 W., W. M.

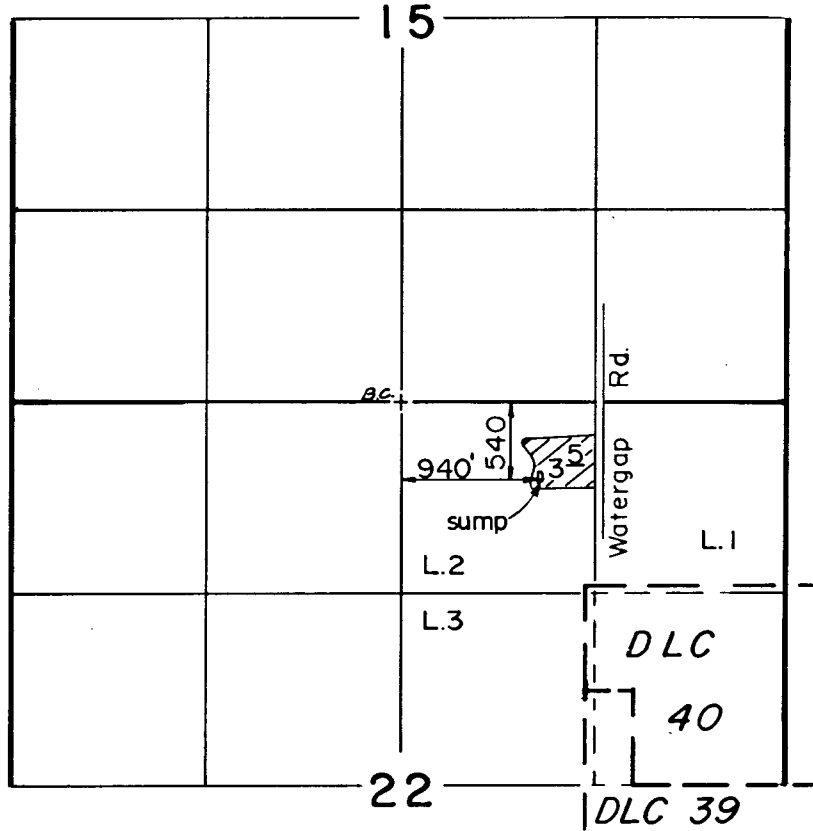

Scale: 1" = 1320'

RECEIVED
APR 24 1991

WM. DIST. 14
GRANTS PASS, ORE.

FINAL PROOF SURVEY UNDER

Application No. G-7152 Permit No. G-6599
IN NAME OF

EUGENE C. SIMS

Surveyed AUG. 16. 1988, by B. S. JAMES