


Application No. G7108  
Permit No. G 6619

T.1N.R.3W.W.M.

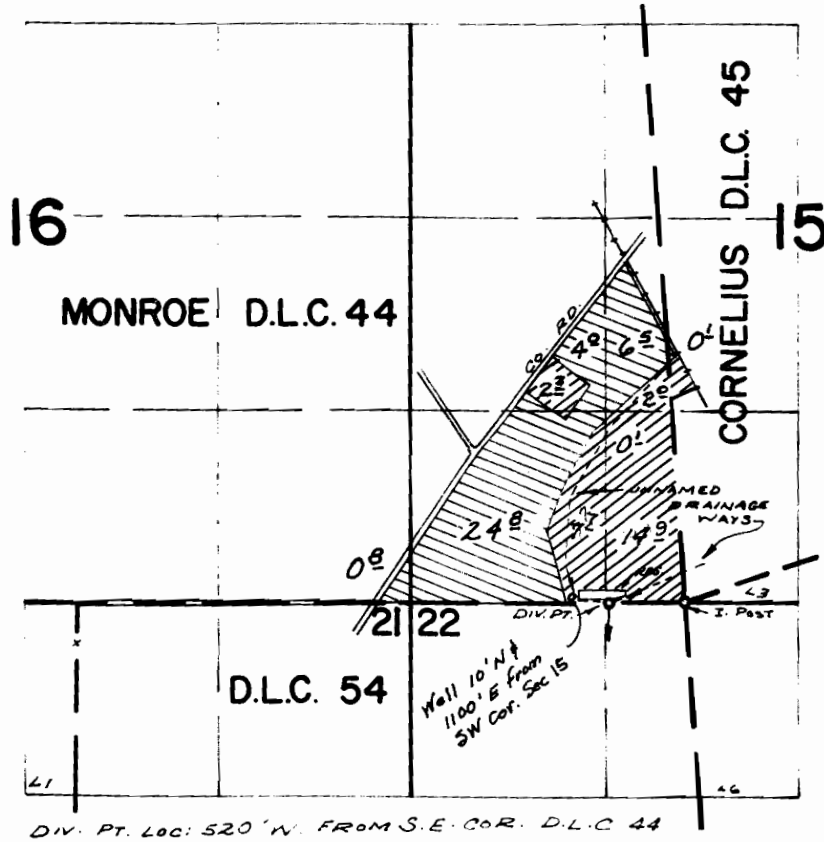

 primary  
 supplemental

~~FINAL PROOF SURVEY~~  
UNDER

Application No. ~~12706~~ ~~12707~~ Permit No. ~~6619~~  
IN NAME OF

JACK DELPLANCHE

Surveyed APR. 22, 1971, by R. MUCKEN.

RECEIVED

FEB - 6 1976

WATER RESOURCES DEPT.  
SALEM, OREGON