



Section 33, Township 16 S., Range 3 W. of the W.M.

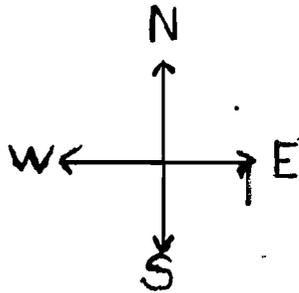

The WELL to be located  
in the NE  $\frac{1}{4}$  of the SW  $\frac{1}{4}$  of  
Section 33, Twp 16 S, Range 3  
W. of the Willamette Meridan  
in Lane County, Oregon:  
100 feet South  
690 feet West  
from the center of said  
Section 33, T.16 S, Rge 3 W.

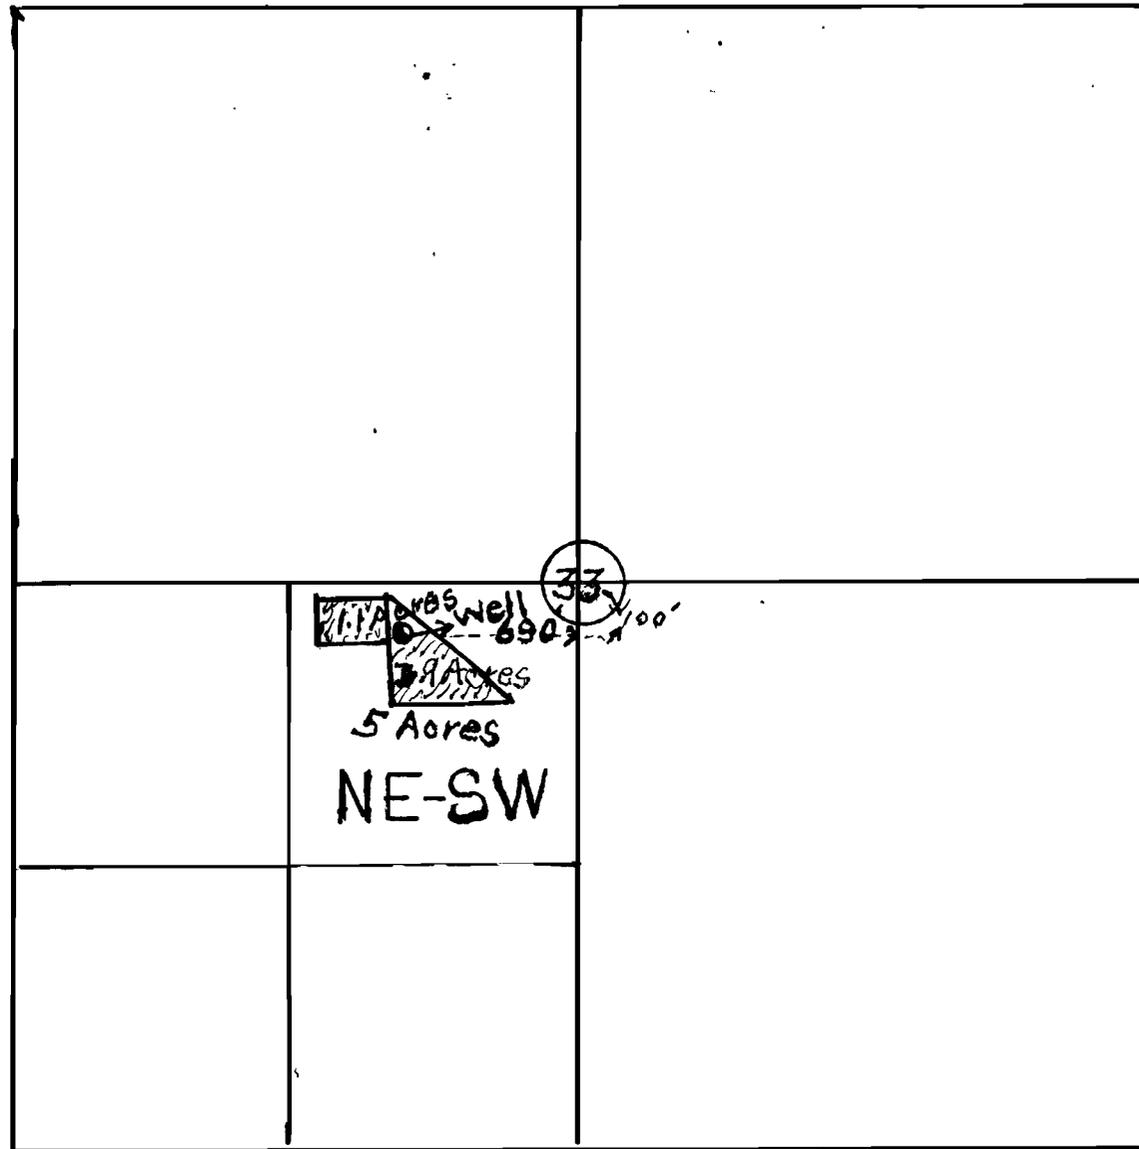

Evva Gandy

Application No. G-729  
Permit No. G-666



Evva Gandy's Property Description

Beginning at the Southeast corner of the land owned and occupied by William Delaney and wife, thence North along the boundary line between Delaney and S. H. Thomas 527 feet to a point where this line intersects the Railroad right-of-way, thence in a Southeasterly course along said Railroad right-of-way to a point due East of the place of beginning, all in Section 33, Township 16, South of Range 3, West of the Willamette Meridian.

Chester L. and Iris M. Gandy's Property Description

Lots 1, 2, 3, 4, 15, 16, 17 and 18 of Block 6 in Dixon & Jarnagin's addition of Coburg, as platted and recorded in Volume 3, Page 2 of Lane County, Oregon Plat Records in Lane County, Oregon.

SE 1/4 NW 1/4

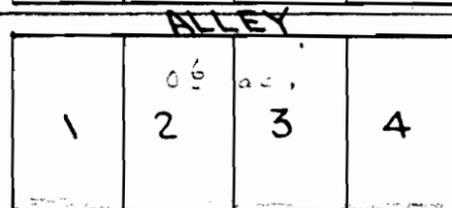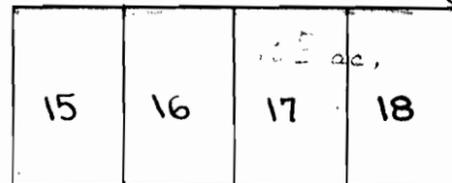

MAPLE ST.

NE 1/4 SW 1/4

527 FT N

320 FT

684 FT E

MARKER AT DELANEY'S  
SOUTHEAST CORNER


6'x6'x3' Stone  
32.80 chs West of the  
SE. Cor. of the John Diamond  
DLC No 44 T 16 S R 3 W

JOHN DIAMOND  
DLC. 44

J. Thomas  
DLC. 60

SCALE 1 IN = 1 FT

DRAWN BY N. GANDY  
7-24-57

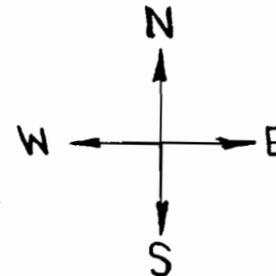

RAILROAD RIGHT-OF-WAY  
868.39 FT  
S 51° 58' E



Application No. G-729  
Permit No. G-666