


Primary Irrigation under Certificate 22377  
from Pudding River

(5)

SW Corner of  
Elias Cox DLC No 43

29

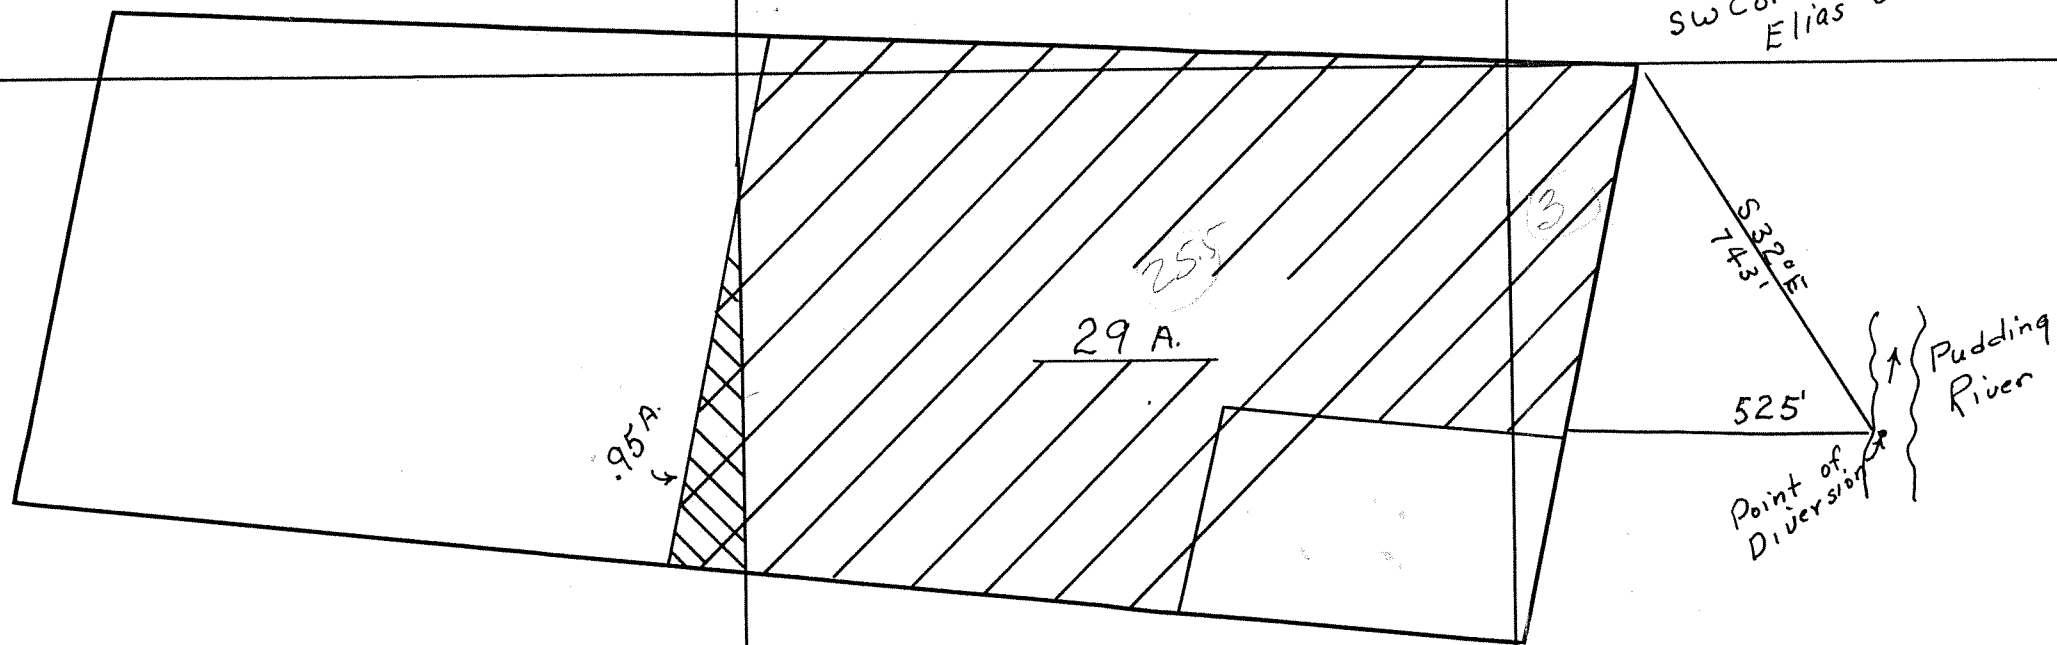

.95 A.

29 A.

S 32° E  
745'

525'

Point of  
Diversion

Pudding  
River

50 SW

OSCAR BOLLINGER

Rt. 2, Box 172 SILVERTON

SEC. 30 - 29.05 ACRES IRRIGATED

SEC. 29 - .95 " "

T6S, R1W - SCALE 1" = 5 chains

Application No. 27115  
Permit No. 21332