


Swanson Bros. Lbr. Co. Well Location Map
Scale 200 ft. = 1 in. Drawn by S. Konnie
T17S R6W

RECEIVED

March 1 1976
WATER RESOURCES DEPT.
SALMON, OREGON

N

Application No. G-7368
Permit No. G 6818

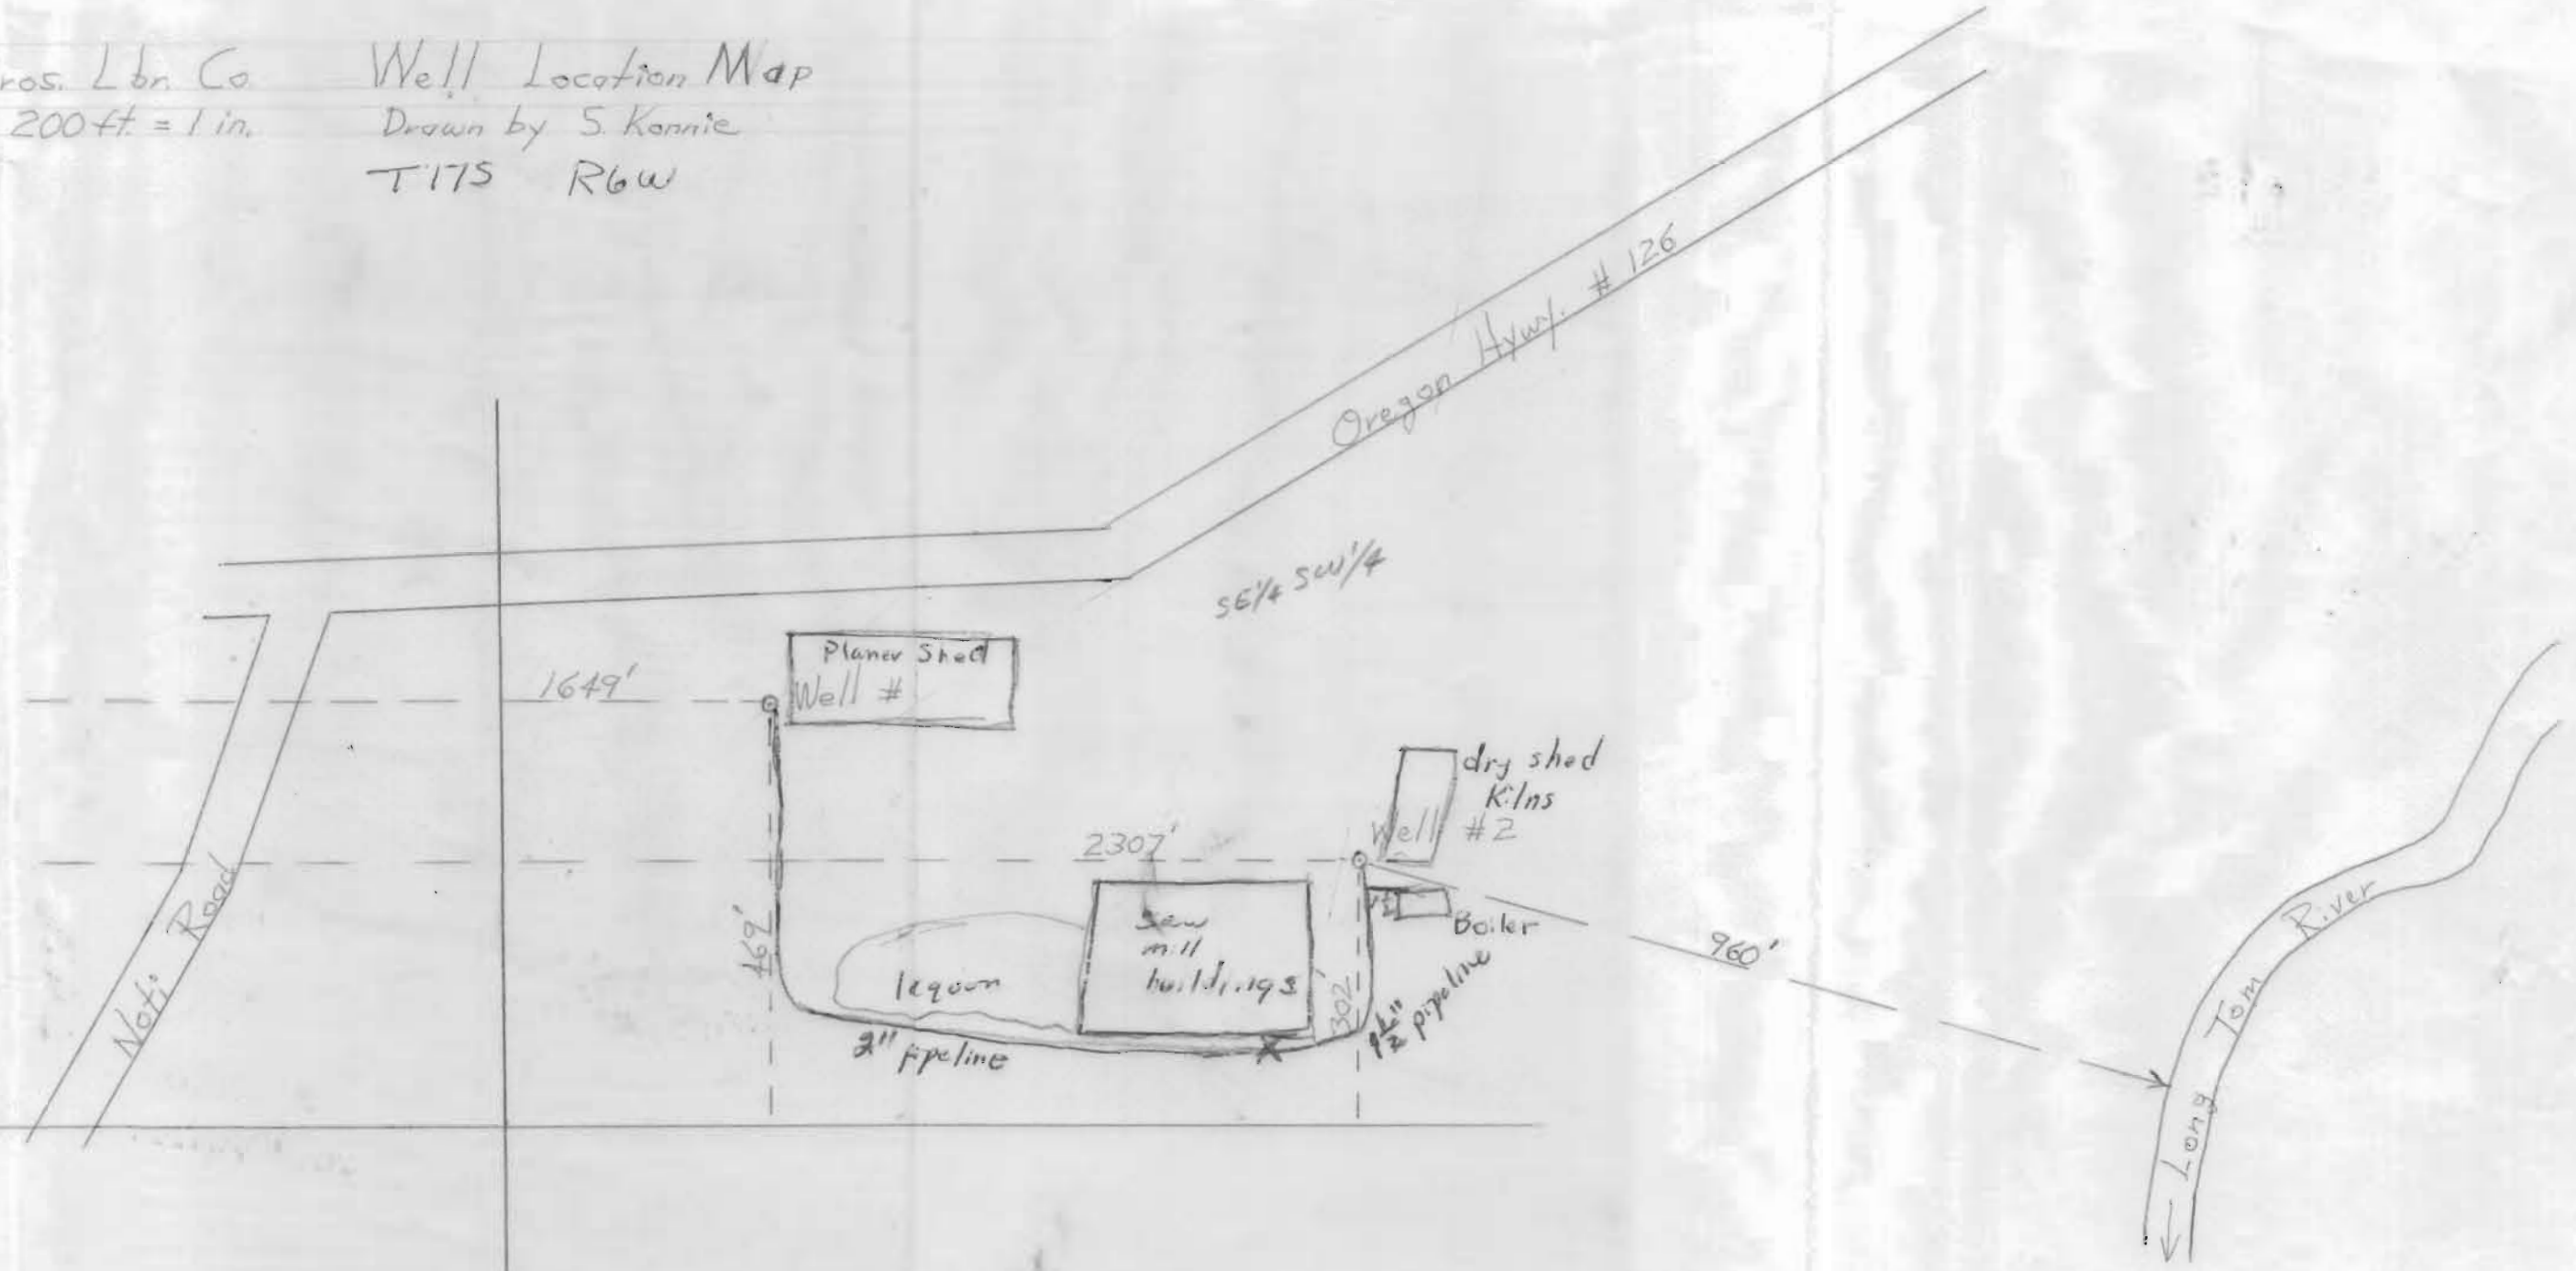

30 29
31 82