


T.34S., R.6W., W.M.

Sec. 12

SE 1/4 SE 1/4

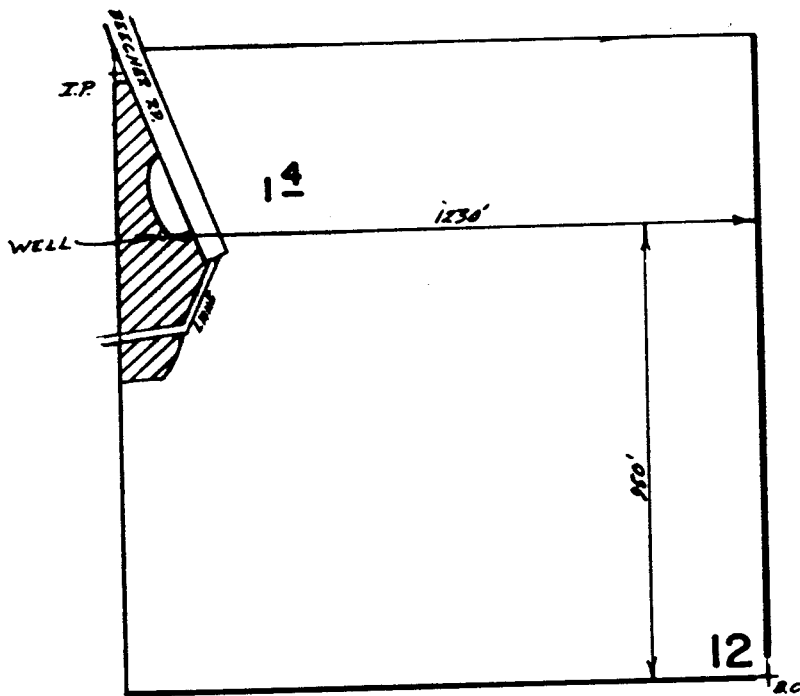

RECEIVED

JUN 3 1988

WM. DIST. 14  
GRANTS PASS, OR.

Scale 1" = 400'

**FINAL PROOF SURVEY**  
UNDER

Application No. G-7374 Permit No. G-6821...  
IN NAME OF

LEONARD.....J.....BLACKLOCK.....

Surveyed Sept. 20, 1984, by J.R. WOODROOF

JO. CO. REC. 62-20-53