


40-7-7
6-6867

T. 40 S., R. 7 & 8 W., W. M.

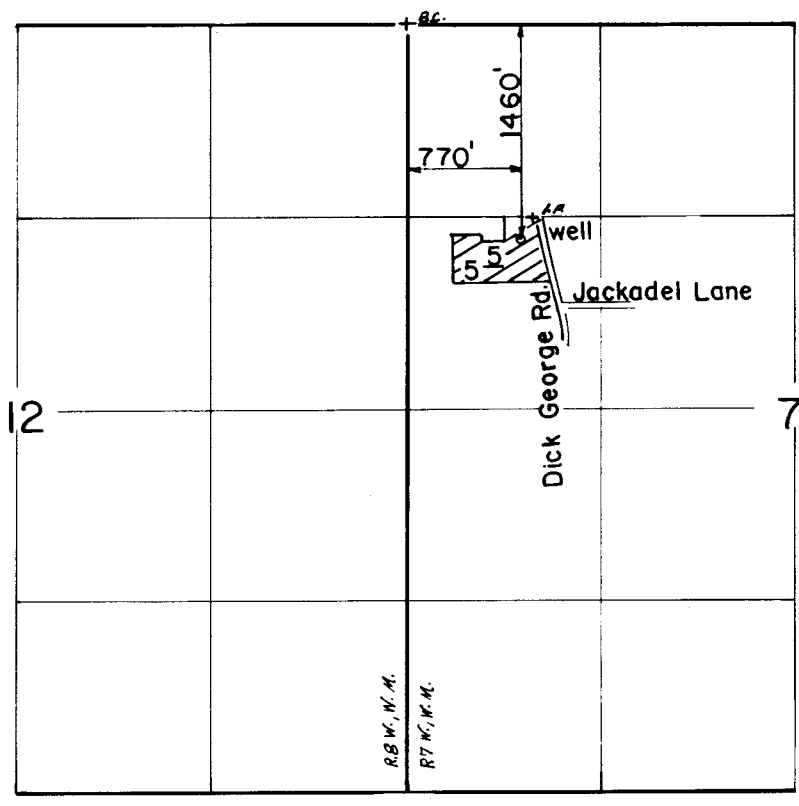

Scale: 1" = 1320'

RECEIVED
OCT 29 1992
WM. DIST. 14
GRANTS PASS, ORE

FINAL PROOF SURVEY UNDER

Application No. G-7357 Permit No. G-6867...
IN NAME OF

.....LEON.....G.....MORTON.....

Surveyed A.P.R. 12. 1988, by B.....S.....JAMES.....

4223-129-276