
## GEO. SETTLEMIER

SEC. 9, T. 10 S., R. 3 W., W.M., LINN CO., ORE.

Scale: 1" = 10 Chains Oct. 15, 1957

ORRIS A. CARNEGIE

DEP. CO. SURVEYOR

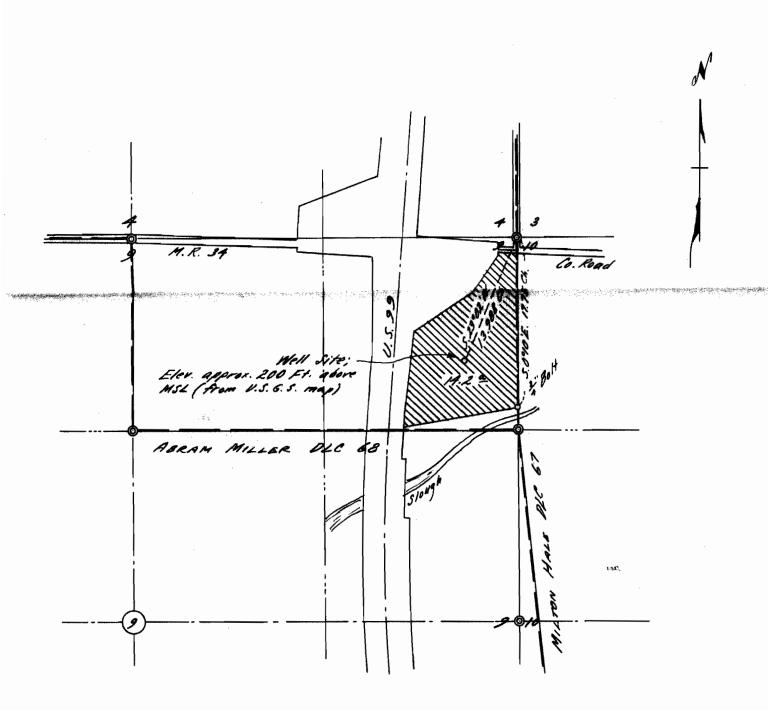

I, Orris A. Carnegie of Albany, Oregon do hereby certify that this map was made from notes taken during an actual survey made by me on October 15, 1957; that the monument shown on this map consisting of a 3/4" iron bolt is S.O°10'E. 17.75 chains from the Northeast corner of Section 9, T. 10 S. R. 3 W. of the Will. Mer. in Linn County, Oregon

REGISTERED OREGON LAND SURVEYOR Occis A. Calengie MAY 9, 1847 ORRIS A. CARNEGIE 213

Application No. G.793
Permit No. G-687