


T.25 S. R.31 E. W.M.

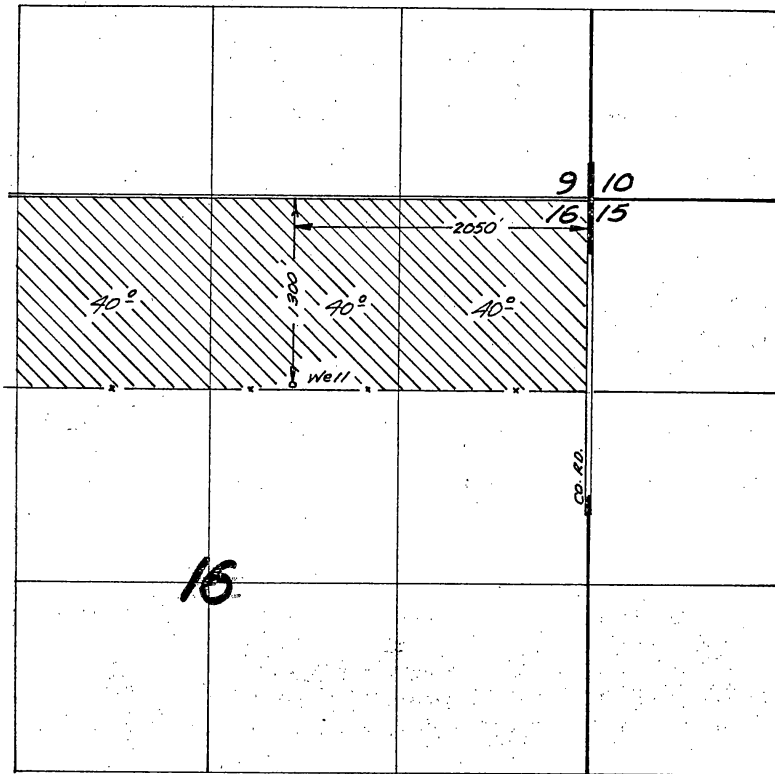

Application No. G-7477

Permit No. G 6961