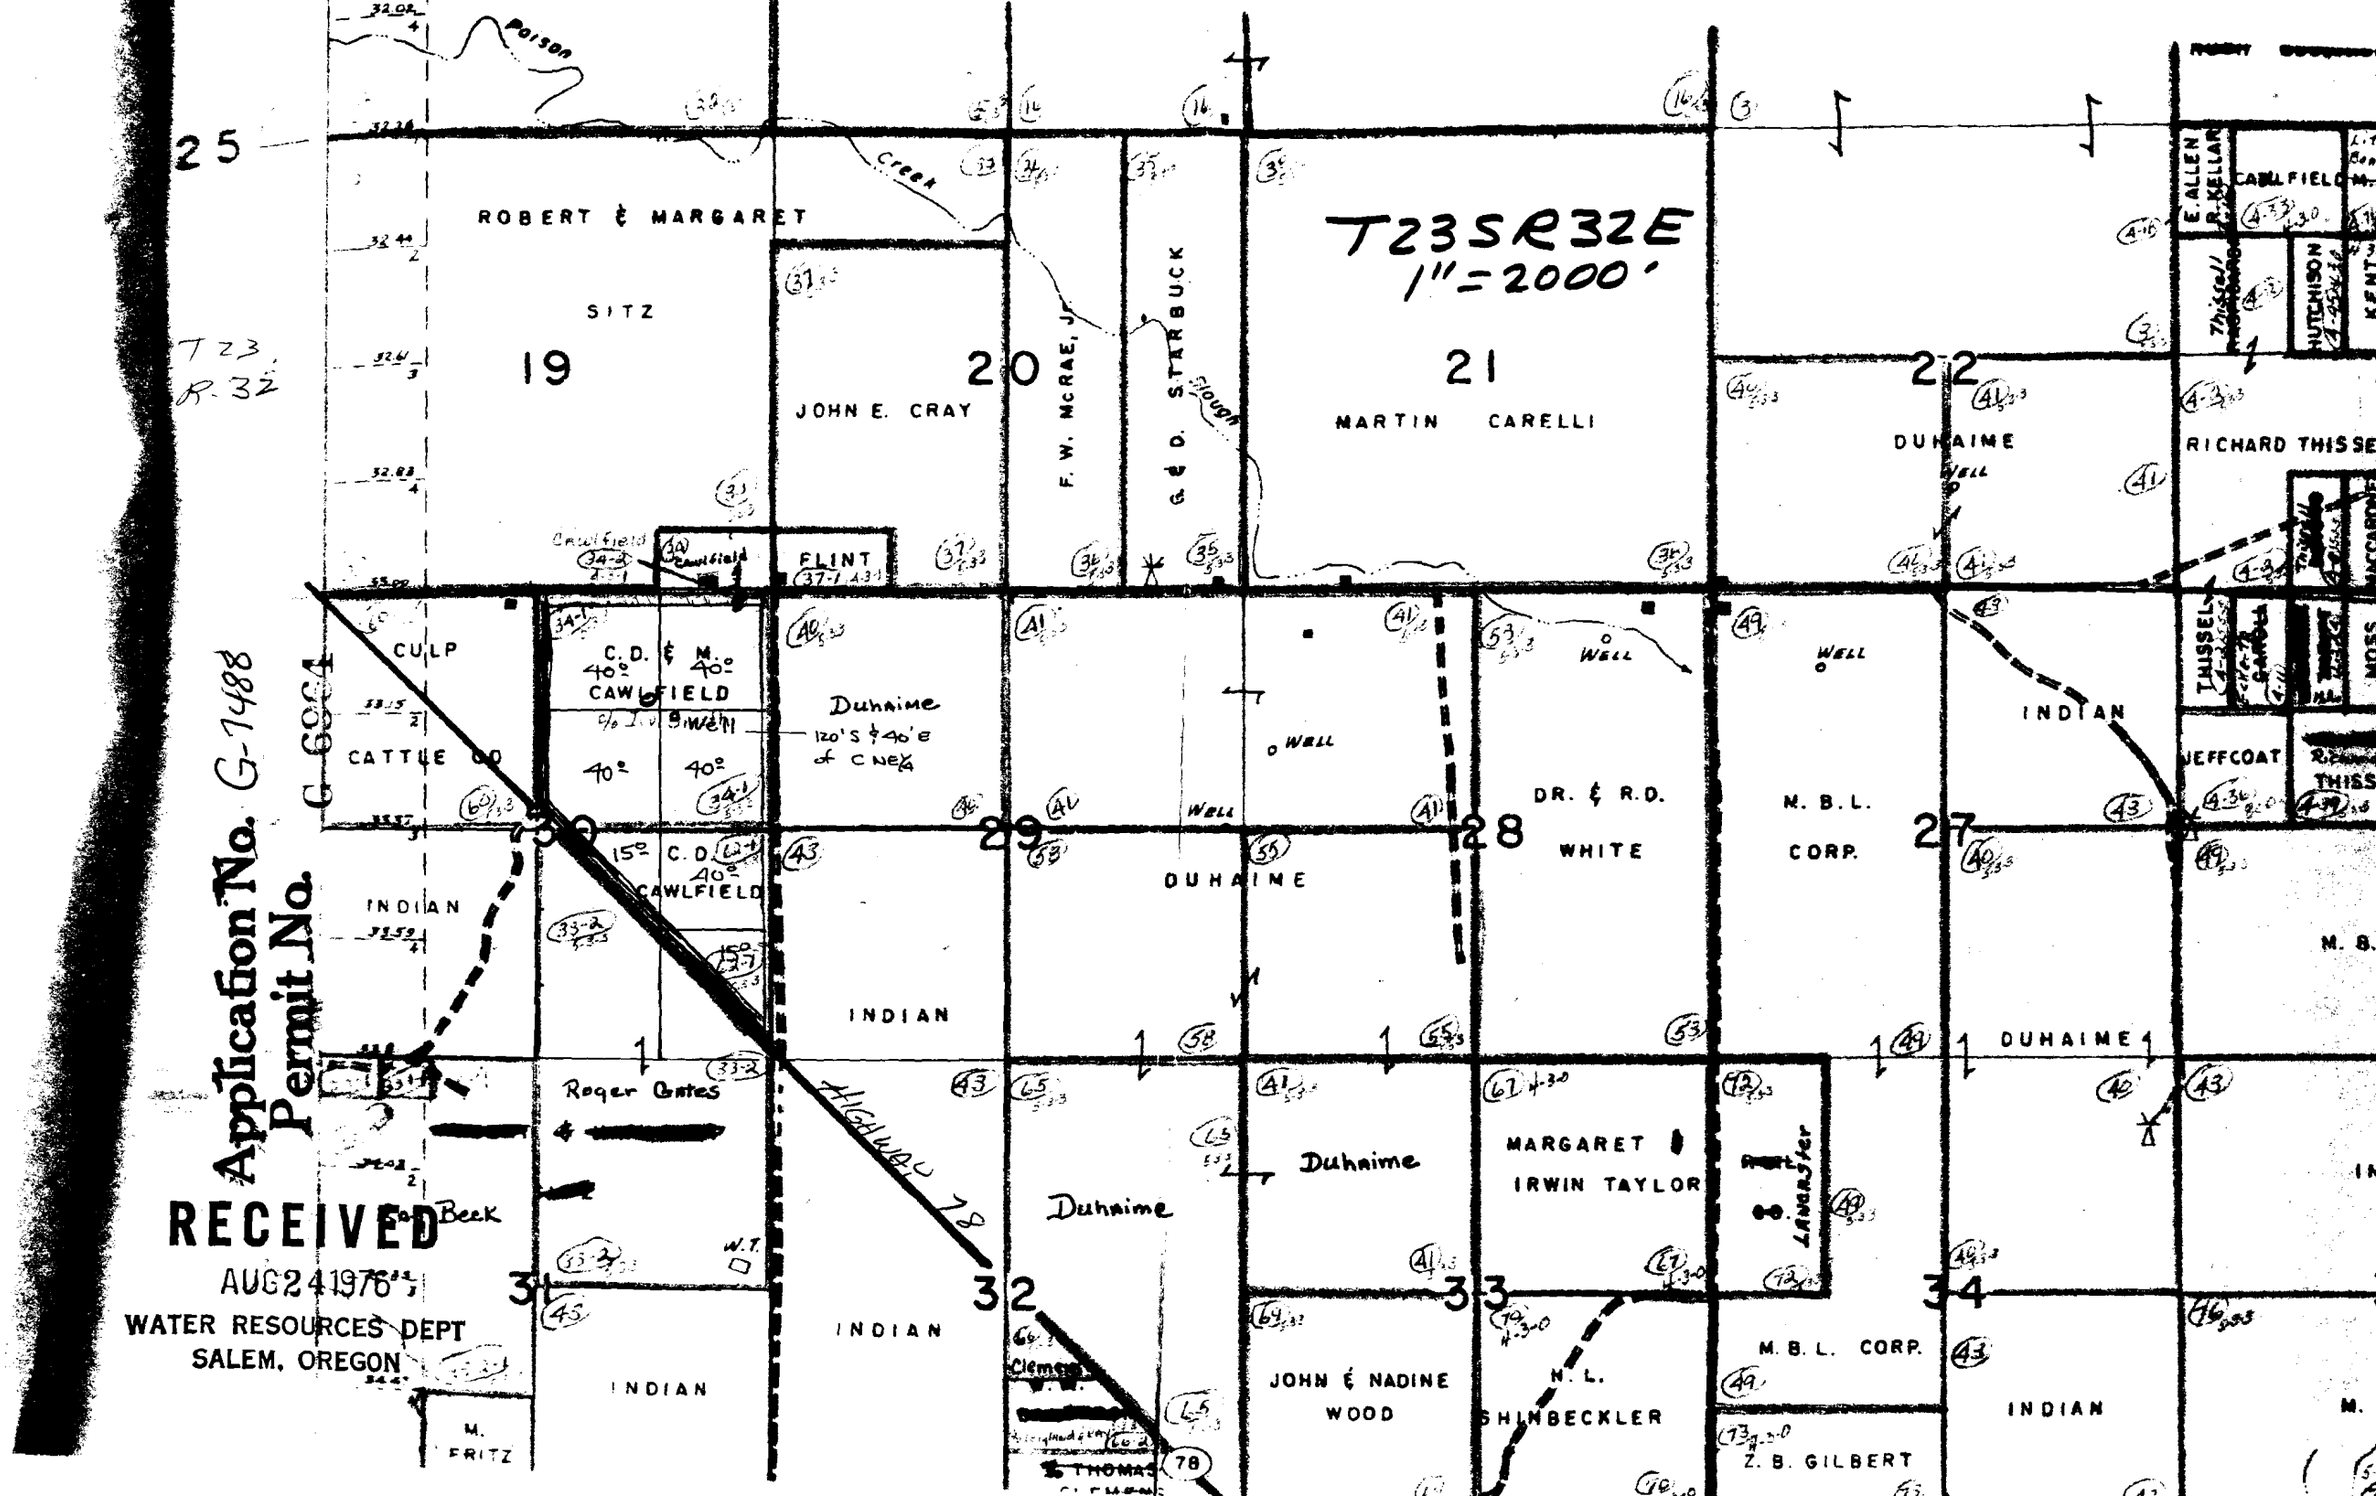
T23S R32E
1" = 2000'
T 23
R. 32
25
ROBERT & MARGARET
SITZ
19
20
JOHN E. CRAY
F. W. McRAE, JR.
G & D. STARBUCK
21
MARTIN CARELLI
22
DUHAIME
RICHARD THISSE
E. ALLEN & R. KELLAR
CAWLFIELD
HUTCHISON
Thissell
CULP
CATTLE CO.
C. D. & M.
40°
CAWLFIELD
40°
40°
Duhaime
120' S & 40' E of C NE¼
FLINT
WELL
INDIAN
15°
C. D.
40°
CAWLFIELD
DUHAIME
DR. & R. D.
WHITE
M. B. L.
CORP.
INDIAN
JEFFCOAT
THISSELL
30
29
28
27
Roger Gates
HIGHWAY 78
Duhaime
MARGARET
IRWIN TAYLOR
Barter
LANASTER
DUHAIME
Creek
W.T.
31
32
33
34
INDIAN
JOHN & NADINE
WOOD
M. L.
SHINBECKLER
M. B. L. CORP.
INDIAN
Z. B. GILBERT
M. FRITZ
Clemens
THOMAS
78
Application No. G-1488
Permit No.
RECEIVED
AUG 24 1976
WATER RESOURCES DEPT
SALEM, OREGON