


T.10S.,R.3W.,W.M.

Application No. G-7502  
Permit No. G 6982

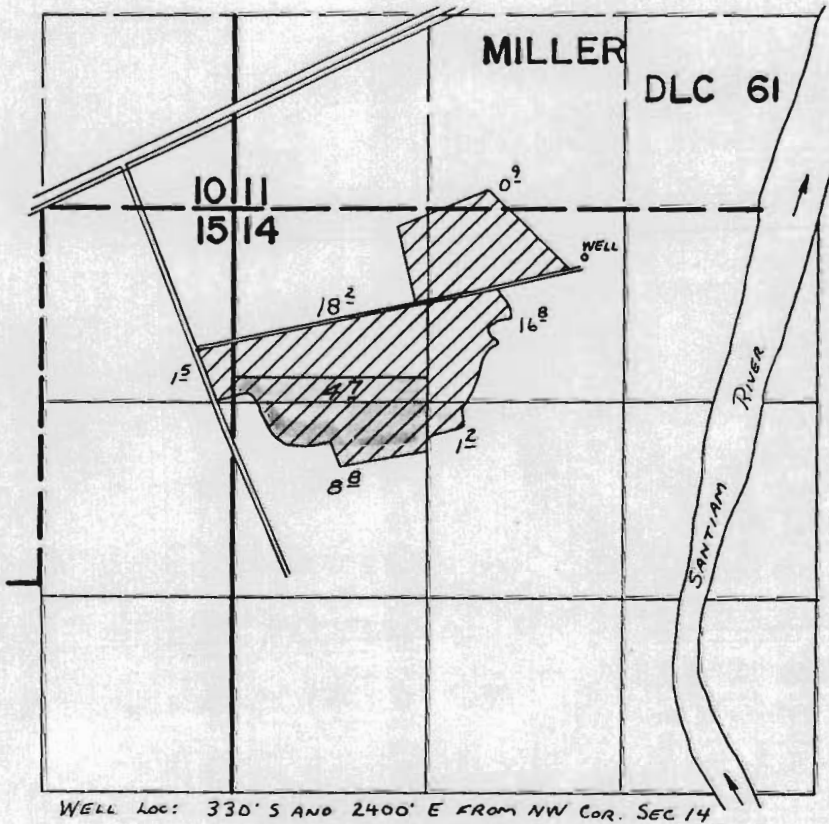

**FINAL PROOF SURVEY**  
UNDER

Application No. G-4206 Permit No. G-3970  
IN NAME OF

GEORGE V. & E. IRENE GRENZ

Surveyed June 22, 1973, by D. Norby