


T. 38 S., R. 8 W., W.M.

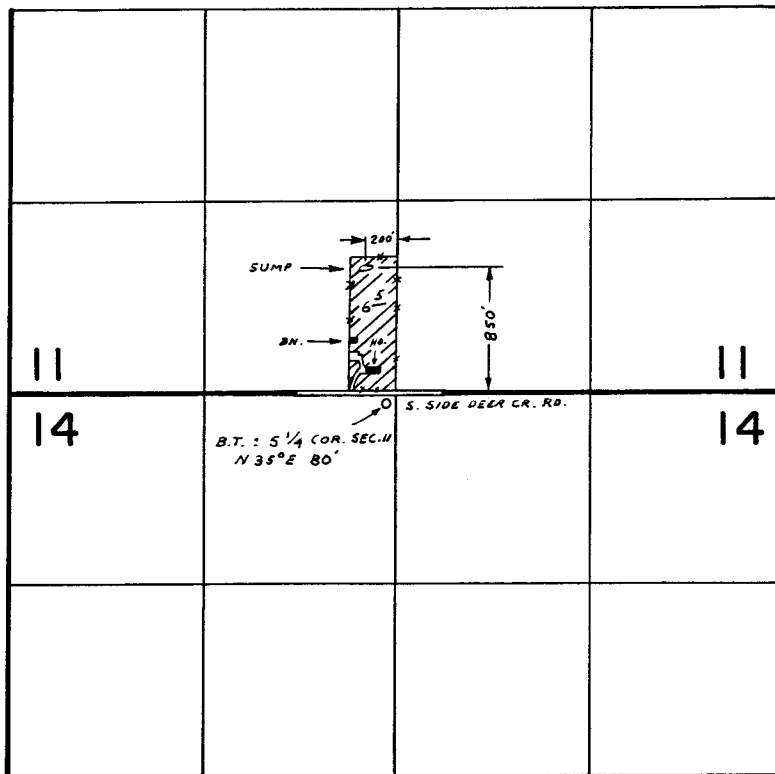

FINAL PROOF SURVEY

UNDER

Application No. G-7504 Permit No. G-6984
IN NAME OF

DON L. METCALF

Surveyed JUL. 19 1978, by B. SUND

P.T.S. - 1978 - 14 - A

WM. DIST. 14
GRANTS PASS, OR.

JUL 12 1979

RECEIVED