


G-6996

35465


7.385. R. / W. W. M.

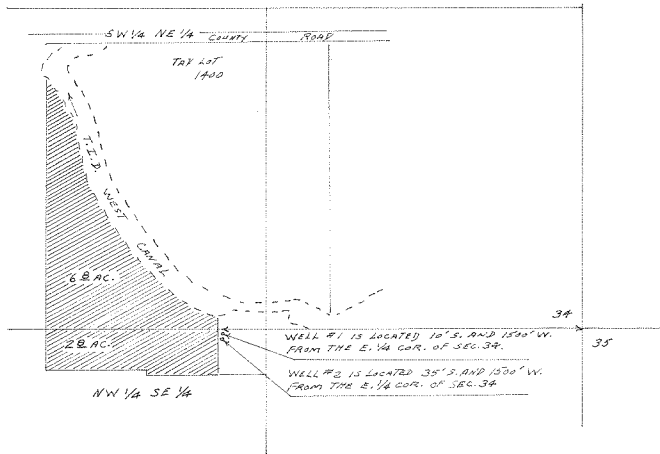

MAP TO ACCOMPANY APPLICATION OF
 WILLIAM R. BAGLEY FOR SUPPLEMENTAL
 IRRIGATION FROM TWO WELLS

SCALE 1" = 400'

Application No. G-7523
 Permit No. G 6996

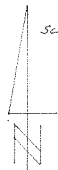

9-17-76