


Well #3

Tp. 27S, R. 17E

Scale 8" = 1 mile

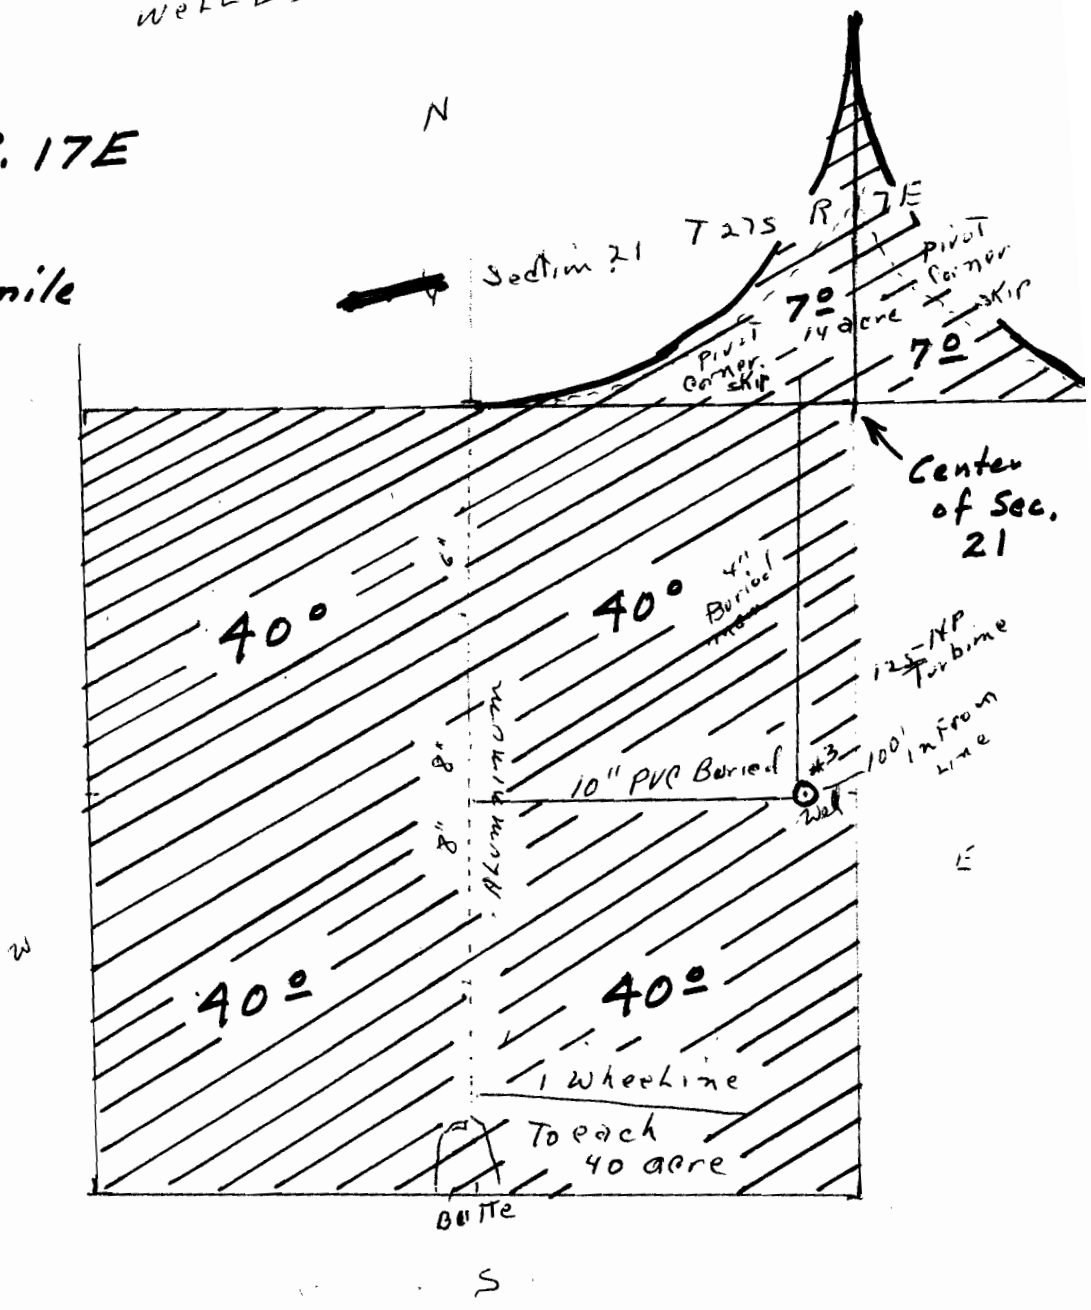

Well #3 Located 1320 ft. N. & 2540 ft E from the SW corner of Sec. 21

RECEIVED
OCT 11 1976

Application No. G-7540
Permit No. G 7011