


T. 34S., R. 5W., W.M.

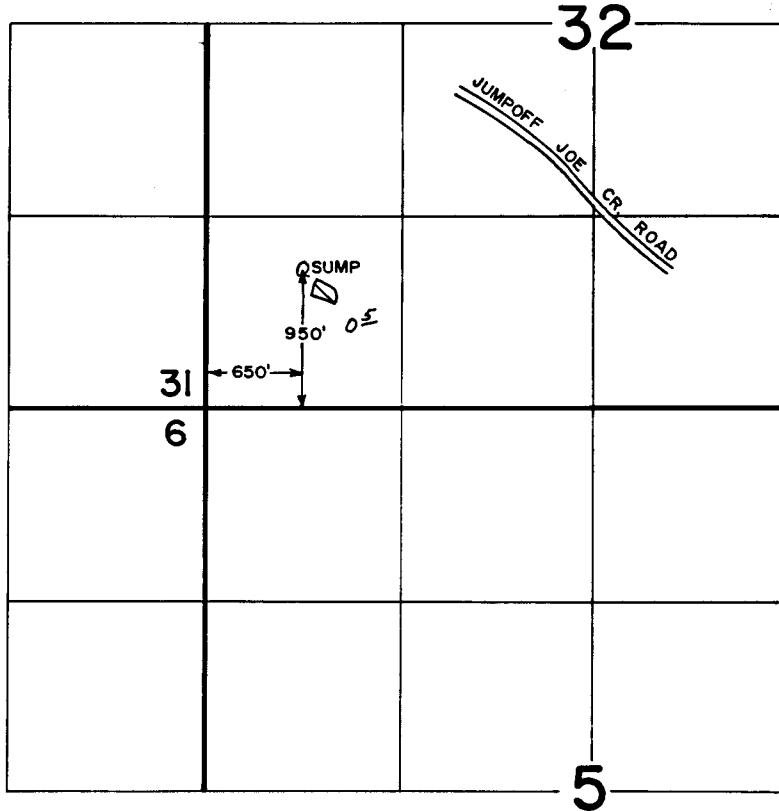

RECEIVED

FEB 02 1987

WM. DIST. 14  
GRANTS PASS, ORE.

**FINAL PROOF SURVEY**  
UNDER

Application No. G-7553 Permit No. G-7021  
IN NAME OF

LEON B. DAVIS

Surveyed SEPT. 14, 1982, by B. S. JAMES

SCALE: 4" = 1 MILE

179-133R TWB