


T.2 S. R.1 E. W.M.,

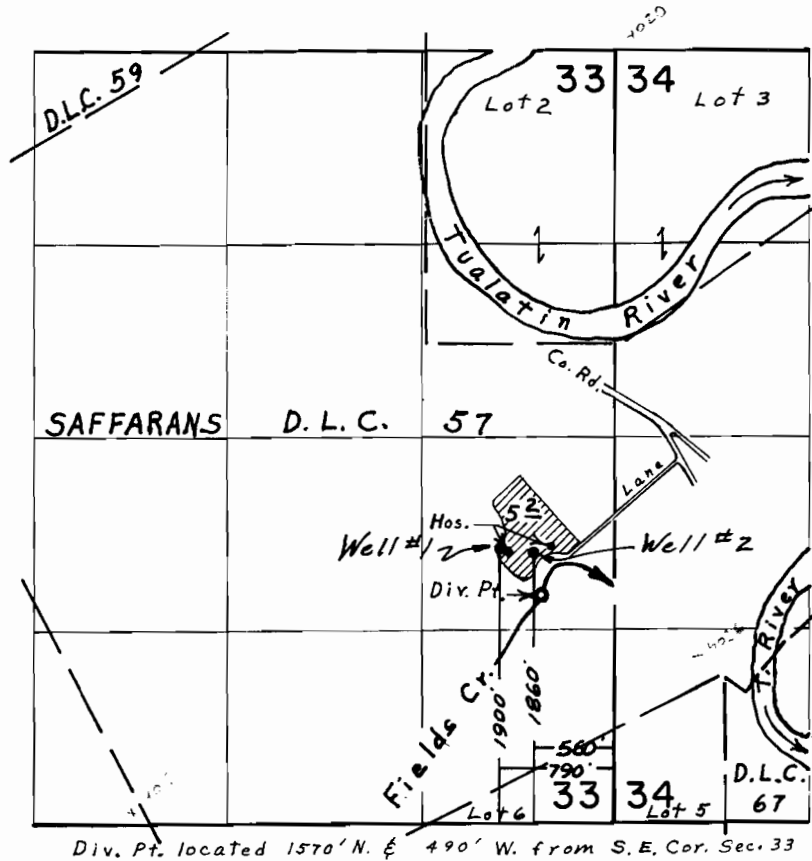

Application No. **G-7600**
 Permit No. **G 7053**

FINAL PROOF SURVEY UNDER

Application No. 47198 Permit No. 35356
 IN NAME OF

STANLEY G. JEWETT, JR.

Surveyed Sept. 30, 1975, by L. E. Gould

RECEIVED

JAN 14 1977

WATER RESOURCES DEPT.
 SALEM, OREGON