


SE 1/4 SEC. 8  
T5S, R1W

RECEIVED  
JUN 2 1977  
WATER RESOURCES DEPT.  
SALEM, OREGON

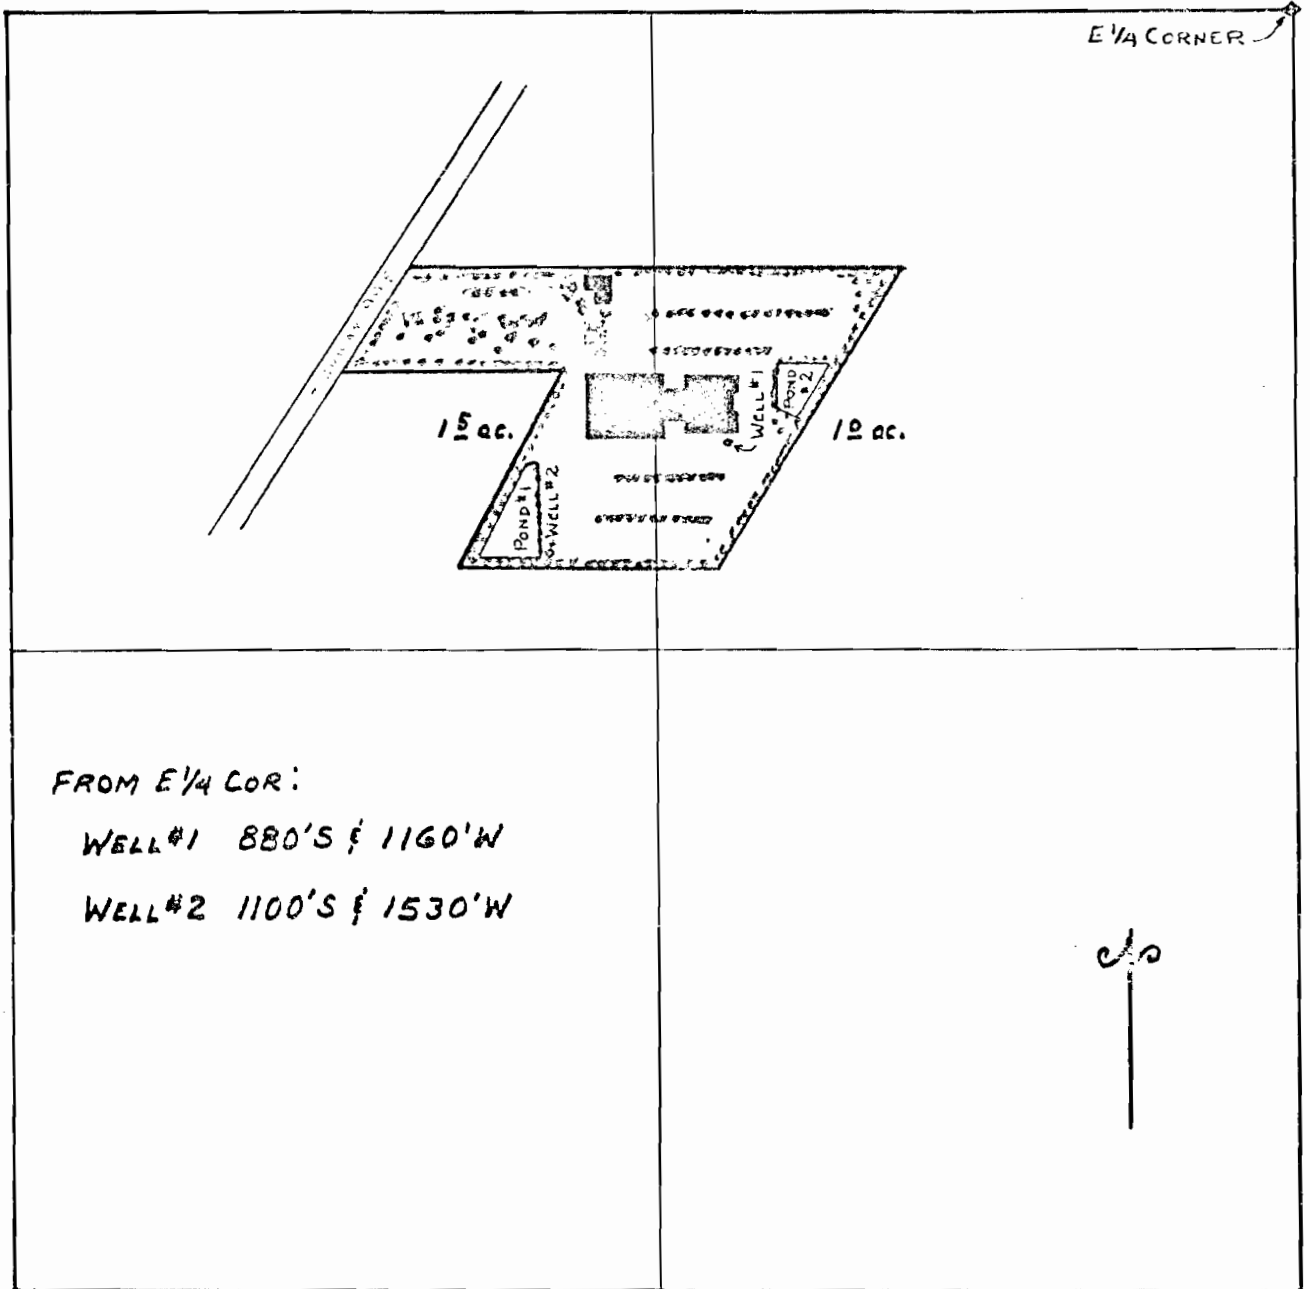

■ BUILDING - AIR COND.

SCALE 1 IN = 400 FT

⊘ LANDSCAPE IRR

Application No. G 7565  
Permit No. G 7088