


T. 9S., R. 40E., W.M.

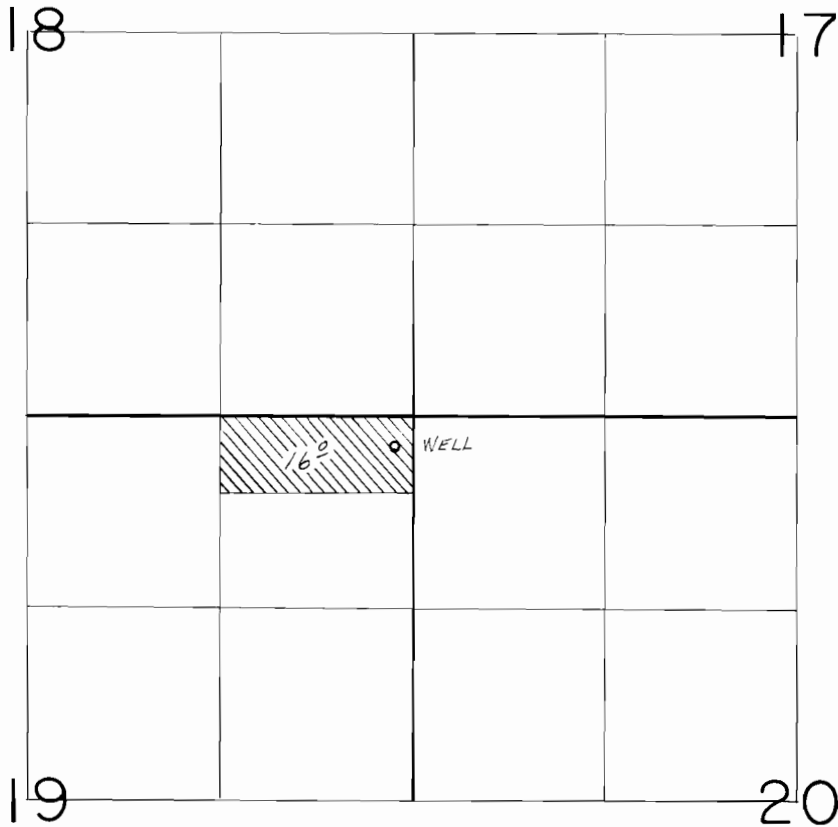

WELL LOC.: 220'S. & 120'W. FROM NE COR. SEC. 19.

SCALE: 1" = 1320'

FINAL PROOF SURVEY
UNDER

Application No. G-7692. Permit No. G-7117.....
IN NAME OF

.....HARRY ALLEN PHILLIPS.....

Surveyed OCT. 8... 19 87, by V.L. CHURCH.....