


Map To Accompany Water Right Application
of
Henry Kildow
in
Section 12, T. 1 S., R. 1 W., W. M.

Scale: 1" = 100' August, 1957

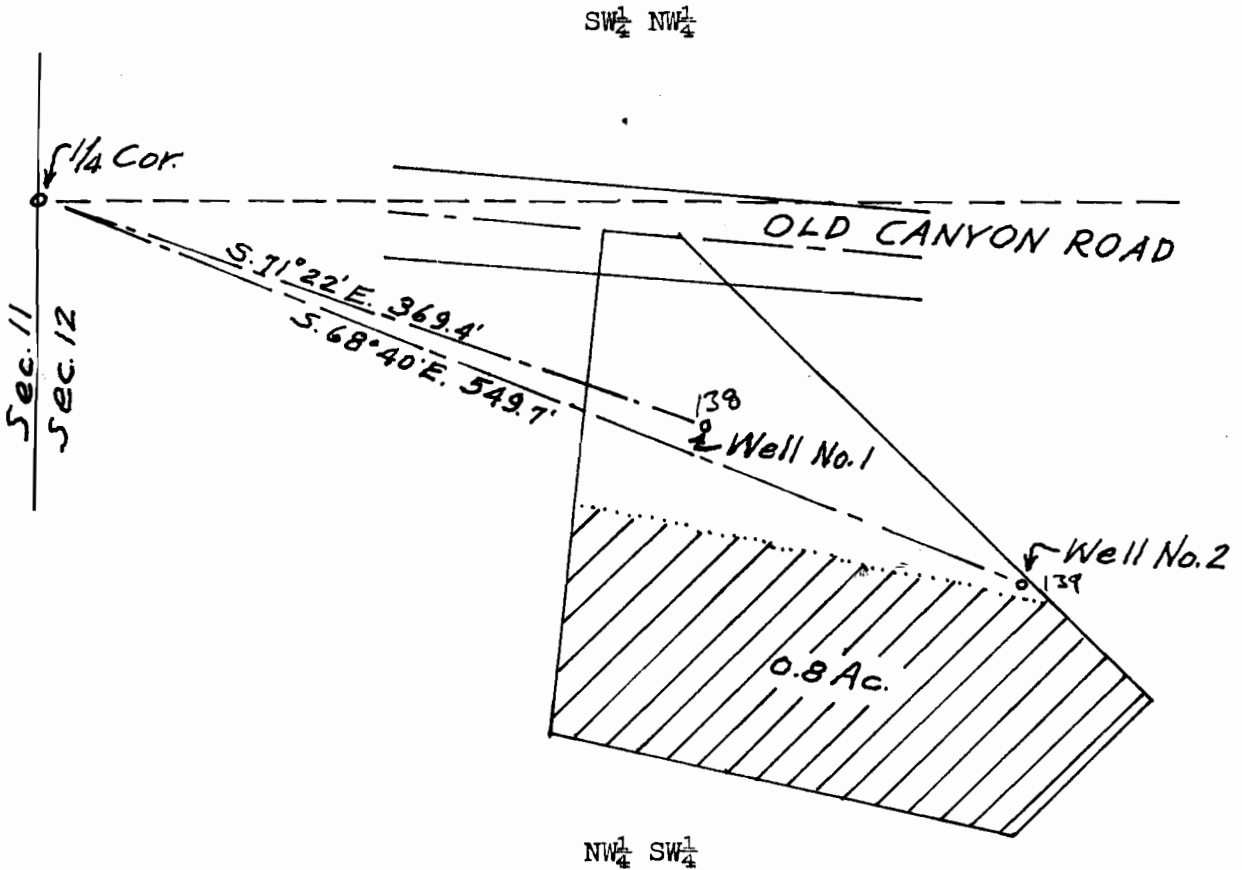

Application No. G-785
Permit No. G-725