


# T.1N.,R.14E.,W.M.

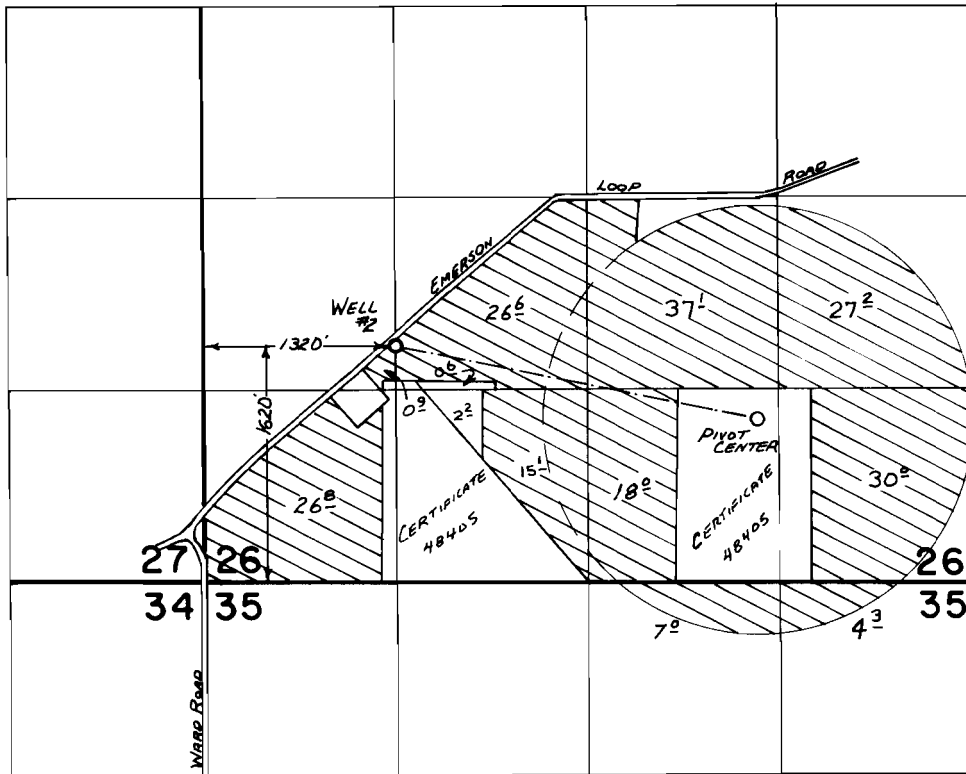

## FINAL PROOF SURVEY UNDER

Application No. G-7438 Permit No. G-7258  
IN NAME OF

GEORGE HARTH

Surveyed Sept. 20, 1982., by T.J. Paul