
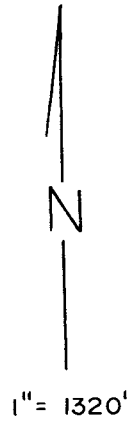


T 39 S., R. 5 W., W.M.

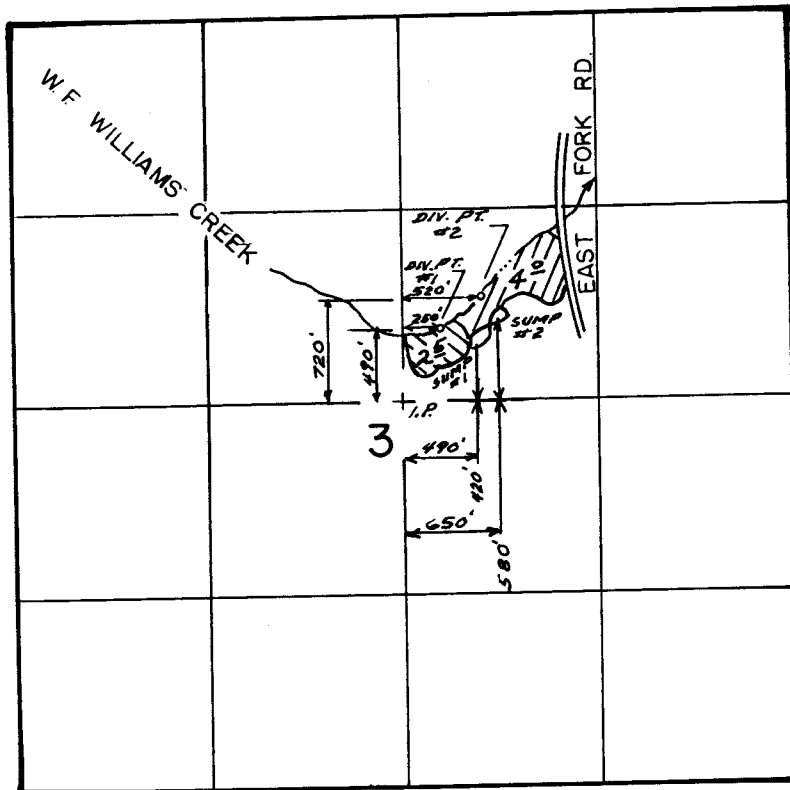

FINAL PROOF SURVEY
UNDER

G-7885

G-7298

Application No. 55430.. Permit No. 41524.....
IN NAME OF

.....GEORGE HUTCHINSON.....

Surveyed AUG. 8 1988, by B.S. JAMES.....

41033-179-107L

LMS
RE-DRAFT DSM 1-15-91