


T. 37 S., R. 6 W., W.M.

RECEIVED

DEC 16 1986

WM. DIST. 14  
GRANTS PAGE ONE

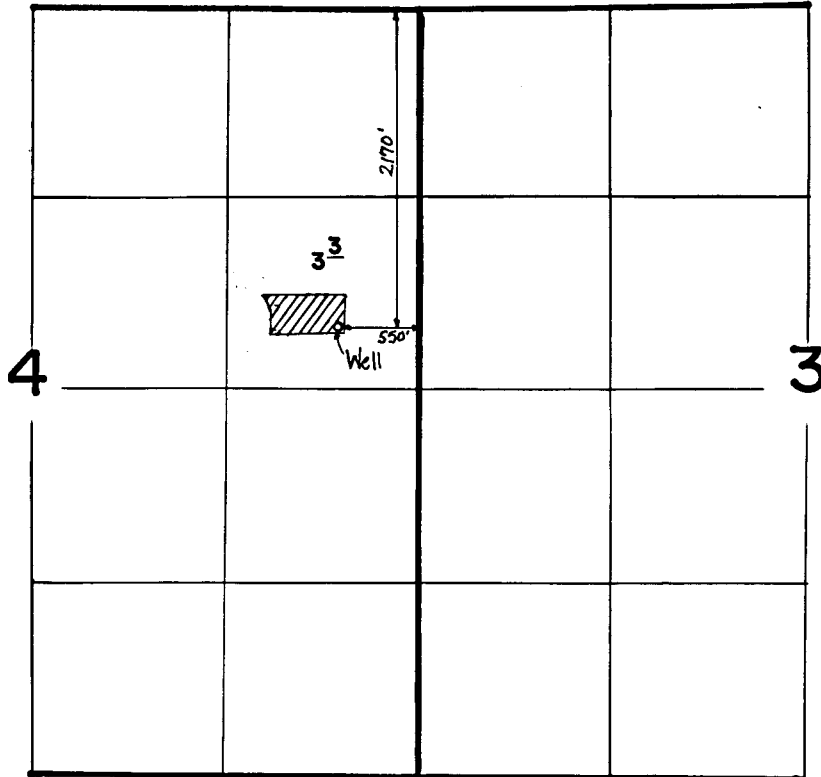

**FINAL PROOF SURVEY**  
UNDER

Application No. G 7955 Permit No. G 7395

IN NAME OF

**SIGNE M. &/OR BONNEY M. CARLSON**

Surveyed AUG. 11, 1982, by B. S. JAMES

850-3-9 me 2/9/89