


Permit: G 7419
Volume: 8
Strm: SUMP WE
Trib: SUCKER CR
Priority: 4/07/77

T. 39 S., R. 8 W., W. VI.

RECEIVED

OCT 8 1980

WM. DIST. 14
GRANTS PASS, ORE.

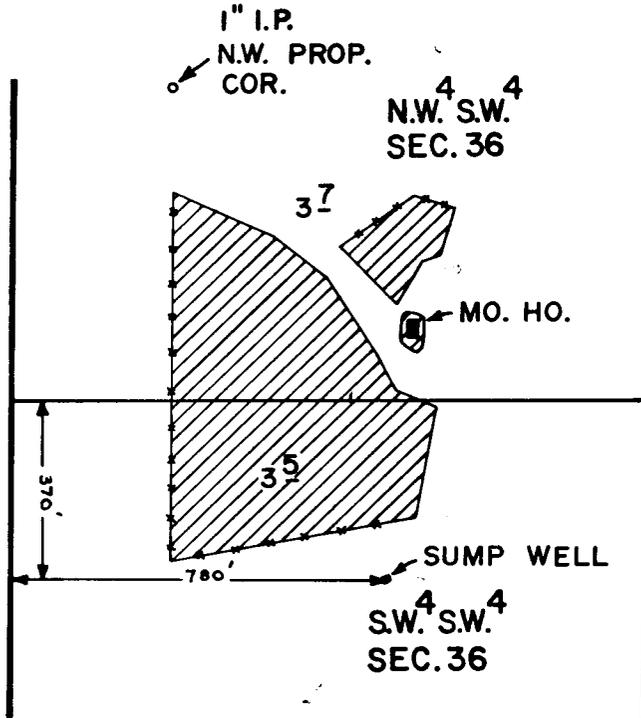

SCALE: 1" = 400 FT.

FINAL PROOF SURVEY UNDER

Cont. 49537
Application No. G-8002 Permit No. G-7419
IN NAME OF

J. GUY DICK

Surveyed APR. 28 1980, by B. SUND

D.H.M.
P.T.S. - 1980-14-A