


T. 36 S., R. 6 W., W.M.

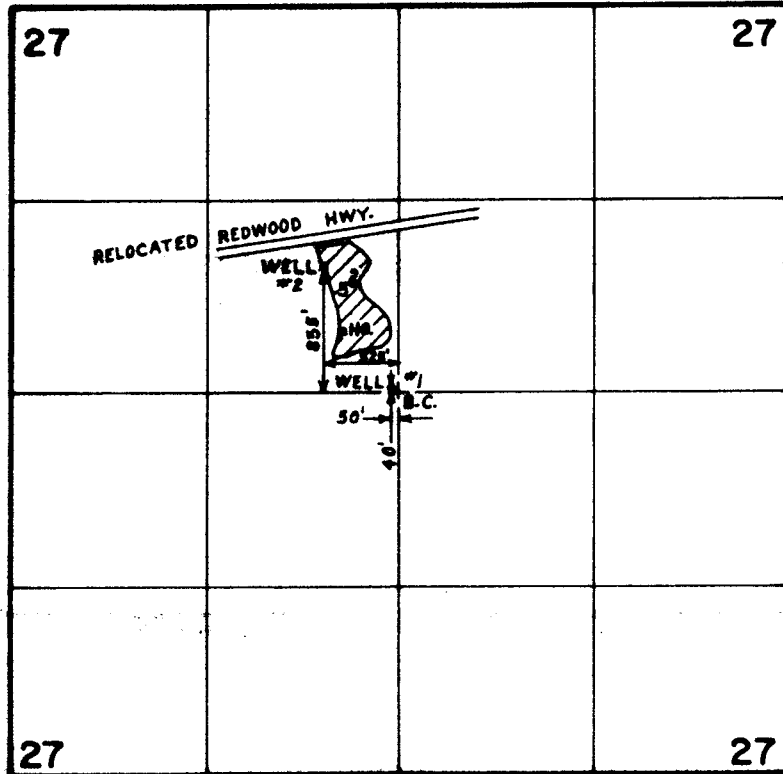

SCALE: 4" = 1 MILE

FINAL PROOF SURVEY UNDER

Application No. G-8022 Permit No. G-7425
IN NAME OF

LLOYD LOGAN

Surveyed JAN. 25 1984, by B. S. JAMES