


T. 40 S., R. 7 W., W. M.

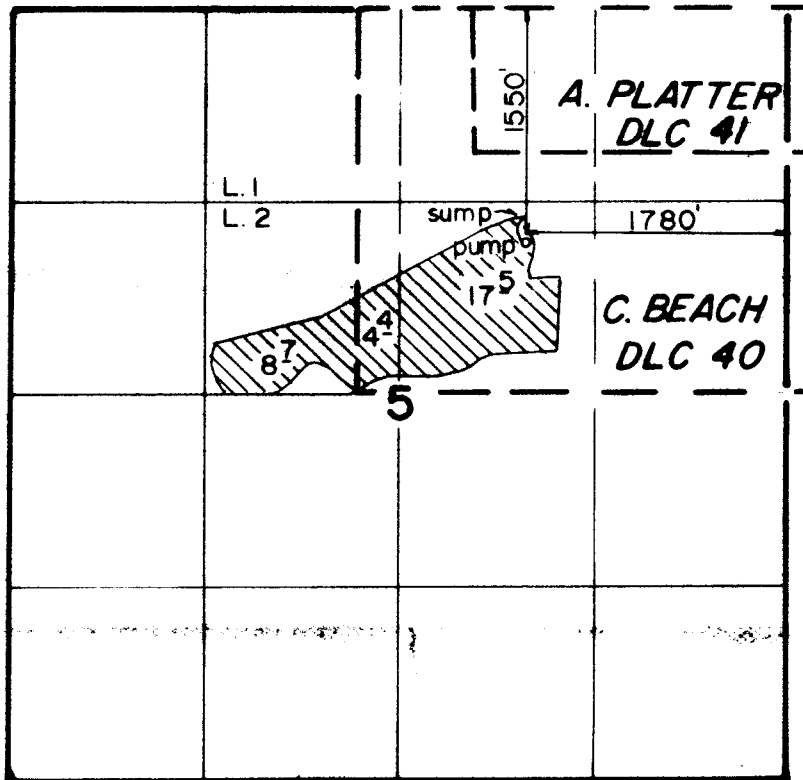

RECORDED

JAN 16 1989

SHA. DIST. 14  
OFFICE PASS. ONE

Scale: 1"=1320'

**FINAL PROOF SURVEY**  
UNDER

Application No. G-7691. Permit No. G-7436  
IN NAME OF

EDWARD LEE & MERIDETH R. (MIDDOUGH) GERBER

Surveyed MAY 12, 1986, by B. S. JAMES.